

HAR.

L 70

3-25-64

WATER WELL DRILLERS LOG

CODED

Date: 3-25, 1964, Driller: Jutter Well Works County Harrison

(Name)

(1) Owner of Land: Jrby Bros.
(Name)
Gulfport Miss.
(Address)

(2) Location: SW 1/4, SW 1/4, Sec. 15 T25R 11W
3 miles N of Gulfport
(distance) (direction) (Nearest Town)

(3) Topography: flat
(Hilly) (Flat) (Level)

(4) Purpose of Well: Industrial
(Domestic Irrigation Municipal, Industrial, Other)

Description & Color of Materials Sand, Clay, Red Clay, Shell, etc.	Thick- ness Feet	Depth Feet
<u>Clay</u>	<u>80</u>	<u>80</u>
<u>sand</u>	<u>30</u>	<u>110</u>
<u>Clay - sand streaks</u>	<u>555</u>	<u>665</u>
<u>sand</u>	<u>119</u>	<u>784</u>

CODED

Information upon completion of well:

(1) Diameter 3 inches.

(2) Total Depth 784 feet.

(3) Water Level 4 feet above below top of ground.

(4) Cased to all, Size 3"


(5) Screen: Size 3", Length 20'

(6) Were any formations sealed against pollution?
no yes, no.

If YES depth of formation _____


Why _____

Drillers Remarks: _____

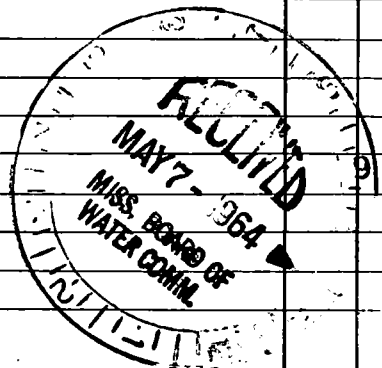

(Use Back Side)

Well No.

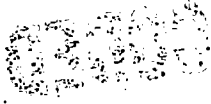

[Faint, illegible text throughout the page, possibly bleed-through from the reverse side or very light handwriting.]