

HAR.
L73

6-11-65

MISSISSIPPI BOARD OF WATER COMMISSIONERS

WATER WELL DRILLERS LOG

CODED

Date: 6-11, 1965, Driller: Arthur Well Works County Harrison
(Name)

(1) Owner of Land: Miss Ida Young
(Name)
Coleman Road Gulfport
(Address)

(2) Location: S W 1/4, S E 1/4, Sec. 8 T 75 R 11 W
5 miles N of Gulfport
(distance) (direction) (Nearest Town)

(3) Topography: hilly
(Hilly) (Flat) (Level)

(4) Purpose of Well: domestic
(Domestic Irrigation
Municipal, Industrial, Other)


Description & Color of Materials Sand, Clay, Red Clay, Shell, etc.	Thick- ness Feet	Depth Feet
Clay	20	20
sand	21	41
Clay - sand streaks	11	152
fine sand	21	173
Clay - sand streaks	18	354
sand	15	369
Clay	87	456
sand	30	486

Information upon completion of well:

- (1) Diameter 2 inches.
- (2) Total Depth 486 feet.
- (3) Water Level 5 feet above below top of ground.
- (4) Cased to all, Size 2"
- (5) Screen: Size 2", Length 10'
- (6) Were any formations sealed against pollution?
no.

CODED

If YES depth of formation _____
Why _____
Drillers Remarks: _____

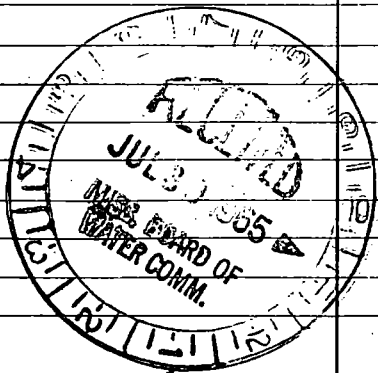

(Use Back Side)

Well No. _____

1950

1950

