

Harrison
L 87
6-66

MISSISSIPPI
BOARD OF WATER COMMISSIONERS
416 North State Street
Jackson, Mississippi 39201

CODED

WATER WELL DRILLERS LOG

6-28 1966 Map Drilling Co. Harrison
date well completed firm name county well located

LANDOWNER: (Robinson Rd)
Audon Pickett
RR. Gulfport, Miss.
(mailing address)

WELL LOCATION:
sec 6 T 7 R 11
4 1/2 miles N of Gulfport
(distance) (direction) (nearest town)


WELL PURPOSE: Home
(home, irrigation, municipal, industrial)

- WELL COMPLETION DATA:
- (1) diameter (inches) 4 1/2
 - (2) total depth (feet) 515
 - (3) static water level (feet) 34 below above top of ground.
 - (4) casing Steel 505 (material) (depth)
4 1/2 if telescope see back. (size)
 - (5) screen 10 FT 505 (length) (depth to top)
2" Brass Underbar (size) (material)
 - (6) pump 1 20 (HP) (yield gpm)
200V 10 (type power)
 - (7) electric log No (yes or no)
Submersible - Ruth Berry (organization running log)
 - (8) how well bottom plugged 2" Back Wash Valve

description of formations encountered	from	to
Surface Clay	0	30
Sand	30	40
White Clay	40	70
Grey Clay	70	95
Brown Sand	95	110
Blue Clay	110	190
Brown Sand -	190	230
Makes Wells - Runny Water		
Blue Clay	230	302
Sand	302	307
Blue Clay	307	425
Fine Sand	425	485
Medium Sand	485	515

Still cutting sand
when drilling stopped
John E. Braden

CODED

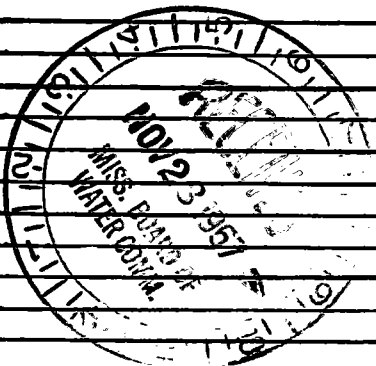

DRILLERS REMARKS:
Pump Set 60 FT.

If well telescopes please sketch and show depths.


GROUND LEVEL

4"
Galvanized

4K2 Bell/Redner
-105

2"
Galvanized

505
2" Brass
Kuddeba
515 Strainer
.008

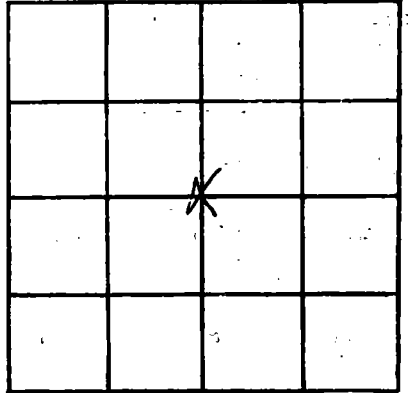

SECTION 6

Please indicate well location. X.

ADDITIONAL INFORMATION

Lined area for additional information.

If more than one screen, show locations of each on sketch.