

Harrison
L 89

8-66

MISSISSIPPI BOARD OF WATER COMMISSIONERS

WATER WELL DRILLERS LOG

CODED

date: Aug 24, 1966, Driller: McB Drilling Co County Harrison
(When well drilled) (Name) (Where well is located)


1) Owner of Land: Mr. Brown
(Name)
58-51st St. Cat Spout, Miss
(Address)
Bogon View -
2) Location: NW 1/4, NW 1/4, Sec. 25 T5S R11W,
N.E. Side Cat Spout
miles _____ of _____
(distance) (direction) (Nearest Town)
3) Topography: Flat
(Hilly) (Flat) (Level)
4) Purpose of Well: Lawn
(Domestic Irrigation
Municipal, Industrial, Other)

Description & Color of Materials Sand, Clay, Red Clay, Shell, etc.	Thick- ness Feet	Depth Feet
<u>Clay - Surface</u>	<u>8</u>	<u>8</u>
<u>White Sand</u>	<u>11</u>	<u>19</u>
<u>White Clay</u>	<u>21</u>	<u>40</u>
<u>White Sand</u>	<u>30</u>	<u>70</u>
<u>" Clay</u>	<u>10+</u>	

CODED

Information upon completion of well:
1) Diameter 2 inches. Plastic
2) Total Depth 70 feet.
3) Water Level 15 feet below top of ground.
4) Cased to 65, Size 2"
5) Screen: Size 2", Length 5 FT.
Flat Plastic
6) Were any formations sealed against pollution?
_____ yes, _____ no.

YES depth of formation _____
Why _____
Drillers Remarks: _____
Yield in gpm: 25 gpm
Size pump: 1 HP Jet 15 gpm
Type power: Ø 200 Volt,

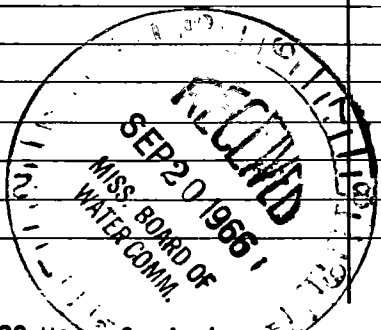

Send this copy to Board of Water Commissioners 429 Miss. St. Jackson, Miss.

COPIED

[The remainder of the page contains extremely faint and illegible text, likely bleed-through from the reverse side of the document.]