

Harrison

L100

10-66

MISSISSIPPI BOARD OF WATER COMMISSIONERS

WATER WELL DRILLERS LOG **CODED**

Date: 10-11, 1966, Driller: C.T. Switzer Well Co. County Harrison
(When well drilled) (Name) (Where well is located)

(1) Owner of Land: Dina Phillips
(Name)
Lond's Cape, N.W. Corner Hwy 48
& Roswell St. R. 3 Box 67
(Address) Gph, Miss

(2) Location: SW 1/4, SE 1/4, Sec 21 T7S R11W
_____ miles _____ of _____
(distance) (direction) (Nearest Town)

(3) Topography: X
(Hilly) (Flat) (Level)

(4) Purpose of Well: domestic
(Domestic Irrigation, Municipal, Industrial, Other)

Description & Color of Materials Sand, Clay, Red Clay, Shell, etc.	Thick- ness Feet	Depth Feet
clay	0	2.1
soft clay	21	31
sand	31	42
sand, logs, gravel	42	63
sand + gravel	63	66
clay	66	141
sand	141	144
clay	144	160
sand	160	166
clay	166	178
fine sand	178	221
clay	221	223
sand	223	226
clay	226	352
sand	352	358
clay	358	371
sand	371	389
clay	389	436
sand	436	466

Information upon completion of well:

(1) Diameter 2 inches.

(2) Total Depth 466 feet.

(3) Water Level 6' feet below top of ground.

(4) Cased to 466', Size 2"

(5) Screen: Size 8 ga ss, Length 16'

(6) Were any formations sealed against pollution?
X yes, _____ no.

YES depth of formation _____

Health Dept. Agents _____


Drillers Remarks: _____

Yield in gpm: _____

Size pump: _____

Type power: _____

CODED

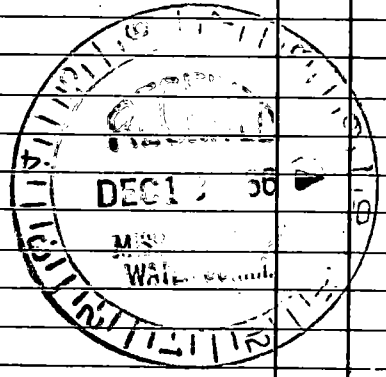

GEICO

Under

...

...

