

Harrison  
L105  
12-66

MISSISSIPPI  
BOARD OF WATER COMMISSIONERS  
416 North State Street  
Jackson, Mississippi 39201

**CODED**

WATER WELL DRILLERS LOG

12-22-66 Hattiesburg Butane Harrison  
date well completed fig name county well located

LANDOWNER: J. M. Stewart  
Rt. 2 John Clark Road  
Gulfport, Miss.  
(mailing address)

WELL LOCATION:  
sec. 6 T. 6 N. R. 11 E  
1 1/2 miles West of Nogenat  
(distance) (direction) (nearest town)


WELL PURPOSE: home  
(home, irrigation, municipal, industrial)

WELL COMPLETION DATA:

- (1) diameter (inches) 2"
- (2) total depth (feet) 188
- (3) static water level (feet) 17 below top of ground.
- (4) casing Galv (material), 175' (depth)  
2" (size) if telescope see back.
- (5) screen 10' (length), 178 (depth to top)  
2" (size), bronze (material)
- (6) pump 1 HP. (HP), 350 (yield gpm)  
Elec (type power)
- (7) electric log no (yes or no)  
(organization running log)
- (8) how well bottom plugged Back Wash Valve

description of formations encountered	from	to
Red sand	0	8
white clay	8	15
Red sand	15	27
Red clay	27	35
Red sand	35	48
white clay	48	59
Blue clay	59	77
white clay	77	92
white sand	92	105
white clay	105	109
Blue clay	109	142
Blue sand	142	188

**CODED**

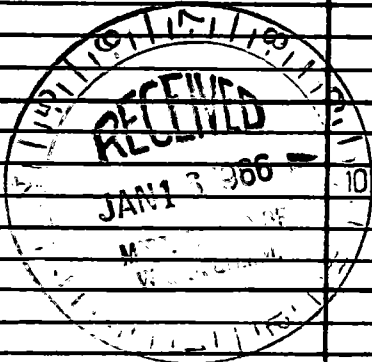

DRILLERS REMARKS:

If well telescopes please sketch and show depths.

GROUND LEVEL


SECTION \_\_\_\_\_

Please indicate well location X.

ADDITIONAL INFORMATION

If more than one screen, show locations of each on sketch.