




If well telescopes please sketch and show depths.

GROUND LEVEL

below ground level

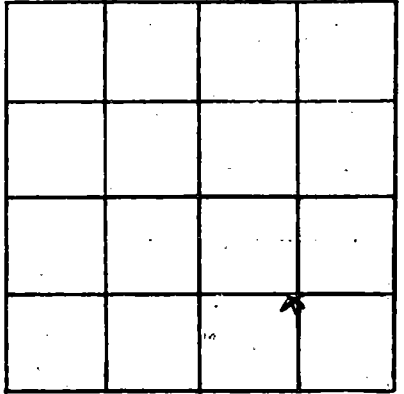

SECTION 21

Please indicate well location X.

ADDITIONAL INFORMATION

If more than one screen, show locations of each on sketch.