

MISSISSIPPI
BOARD OF WATER COMMISSIONERS
416 North State Street
Jackson, Mississippi 39201

CODED

WATER WELL DRILLERS LOG

Harrison
L 108
3-67

date well completed 5-10 1967 firm name Switzer Shell Co county well located Harrison

LANDOWNER Holcomb Asphalt
Three Rivers Rd. 1 blk. E. Hwy 49
P.O. Box 45 Miss. City, Miss.
(mailing address)

description of formations encountered	from	to
	sand	0
clay	4	43
clay + fine sand streaks	43	64
clay	64	80
fine sand	80	86
mixed	86	94
medium sand	94	105
fine sand	105	112

WELL LOCATION:
sec 16 T 7 N R 11 E
S W
8 miles NE of GULFPORT
(distance) (direction) (nearest town)


WELL PURPOSE: Industrial
(home, irrigation, municipal, industrial)

WELL COMPLETION DATA:

- (1) diameter (inches) 3"
- (2) total depth (feet) 112'
- (3) static water level (feet) 8'6" below top of ground.
- (4) casing gal. steel 102'
(material) (depth)
3" if telescope see back.
(size)
- (5) screen 15' 97'
(length) (depth to top)
3" 2 ga ss on pipe
(size) (material)
- (6) pump 1 1/2 30
(HP) (yield gpm)
electric
(type power)
- (7) electric log No
(yes or no)

(organization running log)
- (8) how well bottom plugged back
pressure valve

CODED

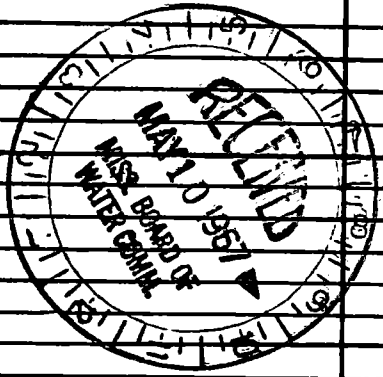

DRILLERS REMARKS:

If well telescopes please sketch and show depths.

GROUND LEVEL

			X

SECTION 16

Please indicate well location X.

ADDITIONAL INFORMATION

If more than one screen, show locations of each on sketch.