

Harrison
 L109
 5-67

MISSISSIPPI
 BOARD OF WATER COMMISSIONERS
 416 North State Street
 Jackson, Mississippi 39201

CODED

WATER WELL DRILLERS LOG

May 17 1967 L.S. Moore Harrison Cty
 date well completed firm name county well located


LANDOWNER: Mr J. E. Byrd
 Route 1 Box 429
 Gulfport Miss
 (mailing address)

WELL LOCATION:
 sec 18 T 7 N R 11 E
 4 miles NORTH of GULFPORT
 (distance) (direction) (nearest town)

WELL PURPOSE: home
 (home, irrigation, municipal, industrial)

- WELL COMPLETION DATA:
- (1) diameter (inches) 2"
 - (2) total depth (feet) 398'
 - (3) static water level (feet) 21' below above top of ground.
 - (4) casing Steel 388'
 (material) (depth)
2" if telescope see back.
 (size)
 - (5) screen 10' 388'
 (length) (depth to top)
2" BRONZE
 (size) (material)
 - (6) pump 3/4 60
 (HP) (yield gpm)
ELECTRIC
 (type power)
 - (7) electric log NO
 (yes or no)
 - (organization running log)
 - (8) how well bottom plugged BACK WASH URINE

description of formations encountered	from to	
TOP SOIL	0	20
Red clay	20	40
Blue & yellow clay	40	125
Blue clay	125	140
Rusty sand	140	160
Blue clay	160	240
Fine Blue sand	240	260
Blue clay	260	368
Medium Blue sand	368	398

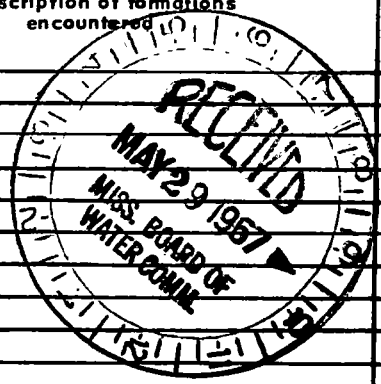

CODED

DRILLERS REMARKS:

If well telescopes please sketch and show depths.

GROUND LEVEL

	X		

SECTION 18

Please indicate well location X.

ADDITIONAL INFORMATION

If more than one screen, show locations of each on sketch.