

HARRISON
L 110
D-67

MISSISSIPPI
BOARD OF WATER COMMISSIONERS
416 North State Street
Jackson, Mississippi 39201

CODED

WATER WELL DRILLERS LOG

May 17 1967 R. J. MOORE HARRISON
date well completed firm name county well located

LANDOWNER: DR. J. E. Byrd
Route 1 Box 479
Gulfport, Miss.
(mailing address)

WELL LOCATION:
sec. 18 T 7 N R 11 E
4 miles South of Gulfport
(distance) (direction) (nearest town)


WELL PURPOSE: HOME
(home, irrigation, municipal, industrial)

WELL COMPLETION DATA:

- (1) diameter (inches) 2"
- (2) total depth (feet) 390'
- (3) static water level (feet) 71' below top of ground
- (4) casing STEEL 2 1/4" 388'
(material) (depth)
2" If telescope see back.
(size)
- (5) screen 10' 388'
(length) (depth to top)
2" BRUNZE
(size) (material)
- (6) pump 1/4 60
(HP) (yield gpm)
ELECTRIC
(type power)
- (7) electric log NO
(yes or no)
(organization running log)
- (8) how well bottom plugged BACKWASH VALVE

description of formations encountered	from to	
	feet	feet
TOP SOIL	0	20
RED CLAY	20	40
BLUE + YELLOW CLAY	40	125
BLUE CLAY	125	140
RUSTY SAND	140	160
BLUE CLAY	160	240
FINE BLUE SAND	240	360
BLUE CLAY	360	368
MEDIUM BLUE SAND	368	398

CODED

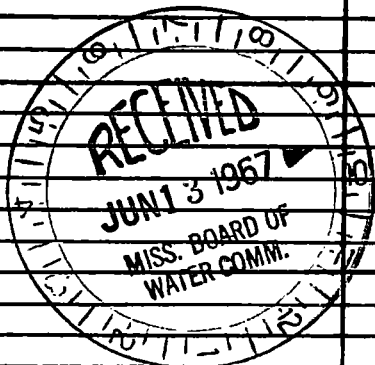

DRILLERS REMARKS: High RATE OF RETURN ON PUMPING LEVEL

If well telescopes please sketch and show depths.

GROUND LEVEL

	X		

SECTION 18

Please indicate well location X.

ADDITIONAL INFORMATION

If more than one screen, show locations of each on sketch.