

Harrison  
 L111  
 6-67

MISSISSIPPI  
 BOARD OF WATER COMMISSIONERS  
 416 North State Street  
 Jackson, Mississippi 39201

**CODED**

WATER WELL DRILLERS LOG

6-19 1967 date well completed Switzer Well Co. firm name Harrison county well located

LANDOWNER: Phyllis Walters

description of formations encountered	from	to
Clay	0	14
Sand	14	24
Clay	24	38
Fine sand	38	59
Medium sand	59	83
Good sand	83	100

Route 1 Box 394  
 Gulfport, Miss.  
 (mailing address)


WELL LOCATION:  
 sec. 8 T. 7 S. R. 11 W.  
8 miles N of GULFPORT  
 (distance) (direction) (nearest town)

WELL PURPOSE: Home  
 (home, irrigation, municipal, industrial)

WELL COMPLETION DATA:

- (1) diameter (inches) 2
- (2) total depth (feet) 100
- (3) static water level (feet) 28 below above top of ground.
- (4) casing gal steel 90'  
 (material) (depth)  
2" if telescope see back.  
 (size)
- (5) screen 10' 90'  
 (length) (depth to top)  
800 SS on pipe  
 (size) (material)
- (6) pump not installed  
 (HP) (yield gpm)
- (type power)
- (7) electric log No  
 (yes or no)  
 (organization running log)
- (8) how well bottom plugged back pressure valve

**CODED**

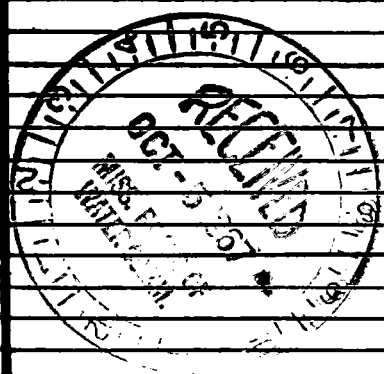

DRILLERS REMARKS:

