


Harrison
L 112
6-67

MISSISSIPPI
BOARD OF WATER COMMISSIONERS
416 North State Street
Jackson, Mississippi 39201

WATER WELL DRILLERS LOG

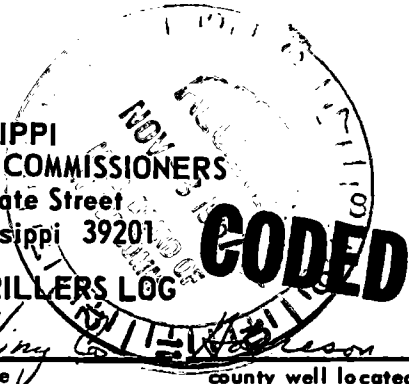

June 19 67 M+B Drilling Co Harrison
date well completed firm name county well located

LANDOWNER: S.T. Bertucci
1416 East Beach
Gulfport, Miss.
(mailing address)

WELL LOCATION:
sec. 3 T 2 S R 11 W
miles of Gulfport
(distance) (direction) (nearest town)

WELL PURPOSE: Home Show
(home, irrigation, municipal, industrial)

WELL COMPLETION DATA:

(1) diameter (inches) ~~4 1/2~~ 4" x 2"
(2) total depth (feet) 760
(3) static water level (feet) 8 below top of ground.
(4) casing Steel, 7.50 (material) (depth)
4 1/2 (size) if telescope see back.
(5) screen 10, 7.50 (length) (depth to top)
2 1/4, Stainless Steel (size) (material) # 8 slot
(6) pump 1 1/2, 20 (HP) (yield gpm)
220V 10 (type power)
(7) electric log No (yes or no)
(organization running log)
(8) how well bottom plugged 2" Brass Back Wash Valve

description of formations encountered	from	to
Sand	0	27
Grey Clay	27	34
Clay + Sea Shells	34	50
Blue Clay	50	54
Fine Sand	54	65
Coarse Sand	65	86
Blue Clay	86	138
Sand	138	147
Grey Clay	147	170
Blue Clay	170	180
Sand + Clay Breaks	180	196
Blue Clay	196	212
Sand	212	217
Blue Clay	217	235
Sand	235	245
Blue Clay	245	285
Sand	285	310
Blue Clay + Sand Breaks	310	347
Blue Clay	347	385
Sand	385	391
Blue Clay	391	412
Sand	412	420
Blue Clay	420	477
Good Sand	477	507
Blue Clay	507	520
Fine Sand	520	570
Blue Clay	570	604
Fine Powder Sand	604	627
Sand - Clay Breaks	627	644
Blue Clay	644	650
Sand + Clay Breaks	650	670
Blue Clay	670	678
Leaves Wood, Black Muck	678	682
Blue Clay	682	705
Fine Sand	705	735
Medium Sand	735	760
Fine Sand	760	765

DRILLERS REMARKS:

If well telescopes please sketch and show depths.

GROUND LEVEL

Screened flow pipe

WATER

100 FT 4H

4x2 Lead Seal at
96 FT
Balance 2"

		X	

SECTION 2

Please indicate well location X.

ADDITIONAL INFORMATION

If more than one screen, show locations of each on sketch.