

HARRISON
L 113
6-67

MISSISSIPPI
 BOARD OF WATER COMMISSIONERS
 416 North State Street
 Jackson, Mississippi 39201

CODED

WATER WELL DRILLERS LOG

6-26 1967 date well completed
 Sutton Well Works firm name
 Harrison county well located

LANDOWNER: John F. Coyne

| description of formations encountered | from | to |
|---------------------------------------|------|----|
| | | |

Box 441

Handboro, Miss.
 (mailing address)

WELL LOCATION:
 sec 24 T 7 R 11 E
 S W
2 miles N of Handboro
 (distance) (direction) (nearest town)


| | | |
|-------------|-----|-----|
| Clay | 0 | 18 |
| Sand | 18 | 32 |
| Clay | 32 | 57 |
| Sand & Clay | 57 | 155 |
| Clay | 155 | 240 |
| Sand | 240 | 277 |

WELL PURPOSE: home
 (home, irrigation, municipal, industrial)

WELL COMPLETION DATA:

- (1) diameter (inches) 2
- (2) total depth (feet) 277
- (3) static water level (feet) 5 below top of ground.
- (4) casing Galv. 267'
 (material) (depth)
2" if telescope see back.
 (size)
- (5) screen 10' 267'
 (length) (depth to top)
2" Stainless steel
 (size) (material)
- (6) pump 1/2 10
 (HP) (yield gpm)
elec
 (type power)
- (7) electric log no
 (yes or no)
 (organization running log)
- (8) how well bottom plugged B.P. Value


CODED

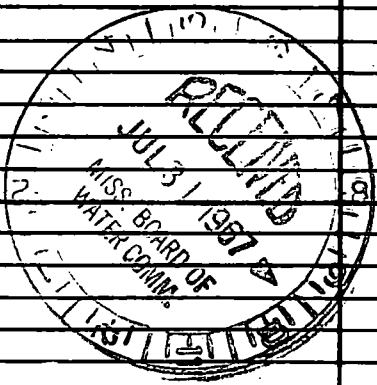

DRILLERS REMARKS:

If well telescopes please sketch and show depths.

GROUND LEVEL

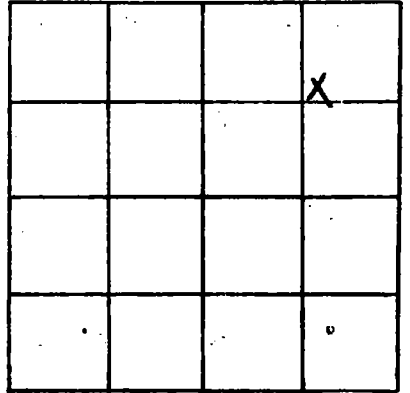

SECTION 24

Please indicate well location X.

ADDITIONAL INFORMATION

If more than one screen, show locations of each on sketch.