

HARRISON
L 115
6-67

MISSISSIPPI
 BOARD OF WATER COMMISSIONERS
 416 North State Street
 Jackson, Mississippi 39201

CODED

WATER WELL DRILLERS LOG

6-29 1967 Hattie's Pure Butane HARRISON
 date well completed firm name county well located

LANDOWNER: Kenneth Bradley
Route 3 Box 365
Gulfport, Miss.
 (mailing address)


WELL LOCATION:
 sec 11 T 7 S 5 R 11 W 4
8 miles North of Gulfport
 (distance) (direction) (nearest town)

WELL PURPOSE: Home
 (home, irrigation, municipal, industrial)

- WELL COMPLETION DATA:
- (1) diameter (inches) 2"
 - (2) total depth (feet) 460'
 - (3) static water level (feet) 24' below above top of ground.
 - (4) casing Alv. pipe 450'
 (material) (depth)
2" if telescope see back.
 (size)
 - (5) screen 10' 450'
 (length) (depth to top)
2" Bronze
 (size) (material)
 - (6) pump 1 450
 (HP) (yield gpm)
Electric
 (type power)
 - (7) electric log NO
 (yes or no)
NO
 (organization running log)
 - (8) how well bottom plugged
BACK WASH VALVE

description of formations encountered	from	to
<u>yellow sand</u>	<u>0</u>	<u>9</u>
<u>yellow clay</u>	<u>10</u>	<u>11</u>
<u>white clay</u>	<u>12</u>	<u>17</u>
<u>white sand</u>	<u>18</u>	<u>26</u>
<u>white clay</u>	<u>27</u>	<u>31</u>
<u>blue clay</u>	<u>32</u>	<u>47</u>
<u>blue sand</u>	<u>78</u>	<u>127</u>
<u>blue clay</u>	<u>128</u>	<u>135</u>
<u>blue sand</u>	<u>136</u>	<u>170</u>
<u>blue clay</u>	<u>171</u>	<u>338</u>
<u>blue sand</u>	<u>339</u>	<u>340</u>
<u>blue clay</u>	<u>341</u>	<u>372</u>
<u>blue sand</u>	<u>373</u>	<u>460</u>

CODED

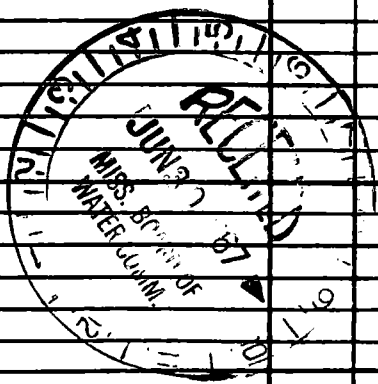

DRILLERS REMARKS:

If well telescopes please sketch and show depths.

GROUND LEVEL

		X	

SECTION 11

Please indicate well location X.

ADDITIONAL INFORMATION

6 miles north of
Chelfort, 1 1/2 miles
east on Redey Road
South side of road -

If more than one screen,
show locations of each on sketch.