

Harrison
 L 117
 7-67

MISSISSIPPI
 BOARD OF WATER COMMISSIONERS
 416 North State Street
 Jackson, Mississippi 39201

CODED

WATER WELL DRILLERS LOG

7-7 1967 date well completed
 Levitzger Well Co. firm name
 Harrison county well located

LANDOWNER Levert Leverett

description of formations encountered	from	to
clay + sand streaks	0	42
Bravel	42	46
clay	46	80
fine sand	80	84
Good sand	84	118

Route 3 Box 131
 Gulfport, Miss
 (mailing address)

WELL LOCATION:
 sec 22 T 7 R 11
 S W
8 miles N of GULFPORT
 (distance) (direction) (nearest town)

Well set at 110'

WELL PURPOSE: Home
 (home, irrigation, municipal, industrial)

WELL COMPLETION DATA:

- (1) diameter (inches) 2
- (2) total depth (feet) 110
- (3) static water level (feet) 5 below top of ground.
- (4) casing gal. steel, 100'
 (material) (depth)
2" if telescope see back.
 (size)
- (5) screen 10', 100'
 (length) (depth to top)
8 gal., SS on pipe
 (size) (material)
- (6) pump 1/3 6
 (HP) (yield gpm)
electric
 (type power)
- (7) electric log No
 (yes or no)

CODED


(organization running log)

(8) how well bottom plugged Back
pressure valve


DRILLERS REMARKS:



If well telescopes please sketch and show depths.

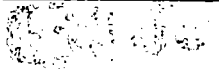

GROUND LEVEL

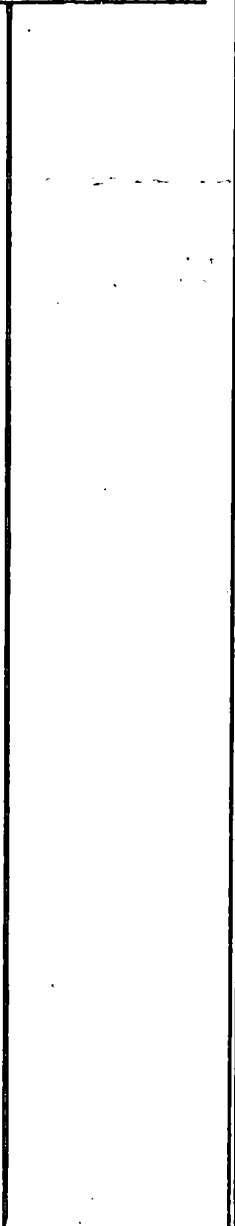

		X	

SECTION 22

Please indicate well location X.

ADDITIONAL INFORMATION

If more than one screen, show locations of each on sketch.