

Harrison  
L 118  
7-67

MISSISSIPPI  
 BOARD OF WATER COMMISSIONERS  
 416 North State Street  
 Jackson, Mississippi 39201

**CODED**

WATER WELL DRILLERS LOG

7-18 1967 Sutter Well Works Harrison  
 date well completed firm name county well located

LANDOWNER: THE AUSTIN Co.

Box 39

GULFPORT, Miss.  
 (mailing address)

WELL LOCATION:

sec. 24 T. 7 S. R. 11 E. W. 3  
1 miles N of Gulfport  
 (distance) (direction) (nearest town)

WELL PURPOSE: Industrial  
 (home, irrigation, municipal, industrial)

WELL COMPLETION DATA:

- (1) diameter (inches) 2
- (2) total depth (feet) 417
- (3) static water level (~~feet~~) 6" <sup>below</sup> above top of ground.
- (4) casing galv. 407'  
 (material) (depth)  
2"  
 (size) if telescope see back.
- (5) screen 10' 407'  
 (length) (depth to top)  
2" stainless steel  
 (size) (material)
- (6) pump 1/2 15  
 (HP) (yield gpm)  
elec  
 (type power)
- (7) electric log No  
 (yes or no)

(organization running log)


(8) how well bottom plugged BP Valve

description of formations encountered

from to

<u>Sandy clay</u>	<u>0</u>	<u>80</u>
<u>clay</u>	<u>80</u>	<u>95</u>
<u>sand</u>	<u>95</u>	<u>110</u>
<u>clay</u>	<u>110</u>	<u>265</u>
<u>sand</u>	<u>265</u>	<u>292</u>
<u>clay</u>	<u>292</u>	<u>392</u>
<u>sand</u>	<u>392</u>	<u>417</u>


**CODED**

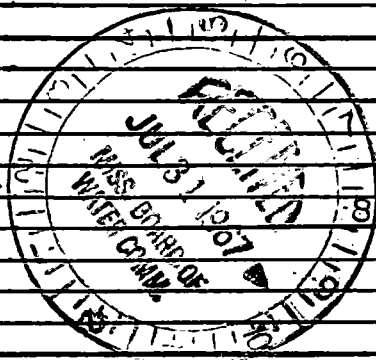

DRILLERS REMARKS:

If well telescopes please sketch and show depths.

GROUND LEVEL

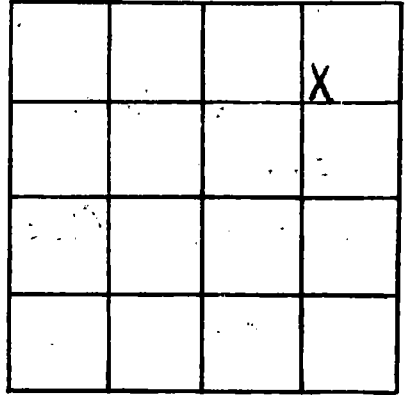

SECTION 24

Please indicate well location X.

ADDITIONAL INFORMATION

If more than one screen, show locations of each on sketch.