

CODED

MISSISSIPPI
BOARD OF WATER COMMISSIONERS
416 North State Street
Jackson, Mississippi 39201

WATER WELL DRILLERS LOG

Harrison
L119
8-67

8-30 1967 Autter Well Works Harrison
date well completed firm name county well located

LANDOWNER: Lillie Newson
1423 Cochran St
New Orleans La
(mailing address)

description of formations encountered	from	to
<u>Clay</u>	<u>0</u>	<u>18</u>
<u>sand</u>	<u>18</u>	<u>49</u>
<u>Clay</u>	<u>49</u>	<u>180</u>
<u>sand</u>	<u>180</u>	<u>220</u>


WELL LOCATION:
sec 18 T 7 R 11
3 miles N of Gulfport
(distance) (direction) (nearest town)

WELL PURPOSE: Home
(home, irrigation, municipal, industrial)

WELL COMPLETION DATA:

- (1) diameter (inches) 2
- (2) total depth (feet) 220
- (3) static water level (feet) 24 below above top of ground.
- (4) casing galv. 210'
(material) (depth)
2" if telescope see back.
(size)
- (5) screen 10' 210'
(length) (depth to top)
2" stainless steel
(size) (material)
- (6) pump 1/2 10
(HP) (yield gpm)
elec
(type power)
- (7) electric log no
(yes or no)
(organization running log)
- (8) how well bottom plugged BP Valve

CODED

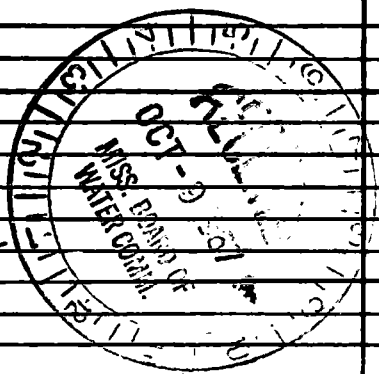

DRILLERS REMARKS:

If well telescopes please sketch and show depths.

GROUND LEVEL

X			

SECTION 18

Please indicate well location X.

ADDITIONAL INFORMATION

If more than one screen, show locations of each on sketch.