

Harrison
L120
8-67

MISSISSIPPI
 BOARD OF WATER COMMISSIONERS
 416 North State Street
 Jackson, Mississippi 39201

CODED

WATER WELL DRILLERS LOG

August 1967 M & B Drilling Co. Harrison
 date well completed firm name county well located

LANDOWNER: Tommy Busby
Three Rivers Rd - RR.
Cultport, Miss.
 (mailing address)

WELL LOCATION:
 sec 3 T 7 R 11
5 miles N of Cultport
 (distance) (direction) (nearest town)


WELL PURPOSE: Home
 (home, irrigation, municipal, industrial)

WELL COMPLETION DATA:

- (1) diameter (inches) 2"
- (2) total depth (feet) 230
- (3) static water level (feet) 44 below above top of ground.
- (4) casing PVC, 234
 (material) (depth)
- 2" if telescope see back.
 (size)
- (5) screen 6ft, 234
 (length) (depth to top)
- 2", PVC Sand Pac
 (size) (material)
- (6) pump 1/2, 8
 (HP) (yield gpm)
- 110V 1φ
 (type power)
- (7) electric log No
 (yes or no)
- (organization running log)
- (8) how well bottom plugged PVC Cap

description of formations encountered	from	to
Surface	0	15
Sand	15	25
White Clay	25	30
White Clay Sand Gravel	30	50
Brown Clay	55	63
White Clay	63	67
Blue Clay	67	85
Black Muck & Sand	85	90
Blue Clay	90	120
Fine Sand & Clay Breaks	120	150
Dark Grey Clay	150	185
Blue Clay	185	200
Grey Sand	200	230

CODED

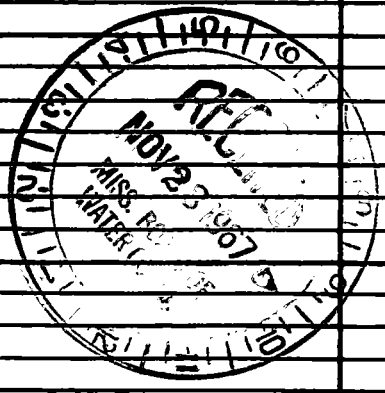

DRILLERS REMARKS:

If well telescopes please sketch and show depths.

GROUND LEVEL

			X

SECTION 3

Please indicate well location X.

ADDITIONAL INFORMATION

If more than one screen, show locations of each on sketch.