

Harrison
L121
10-67

MISSISSIPPI
BOARD OF WATER COMMISSIONERS
416 North State Street
Jackson, Mississippi 39201

CODED

WATER WELL DRILLERS LOG

Oct 27 1967 19 R.S. Moore Harrison
date well completed firm name county well located


LANDOWNER: C.H. CAPLE
RT 3 Box 2348A
GULSPORT
(mailing address)
WELL LOCATION:
sec. 4 T. 7 N. R. 11 E.
6 miles North of Gulspoor
(distance) (direction) (nearest town)

description of formations encountered	from	to
Top Soil	0	10
Sand & Gravel	10	15
White Clay	15	30
White rusty sand	30	104

WELL PURPOSE: Home
(home, irrigation, municipal, industrial)

WELL COMPLETION DATA:
(1) diameter (inches) 2"
(2) total depth (feet) 104 ft
(3) static water level (feet) 35 below above top of ground.
(4) casing 2" galv, 94'
(material) (depth)
(size) if telescope see back.
(5) screen 10 ft, 94'
(length) (depth to top)
2", stainless steel
(size) (material)
(6) pump _____ (HP) _____ (yield gpm)
(type power)
(7) electric log NO
(yes or no)
(organization running log)
(8) how well bottom plugged back
wash valve

CODED

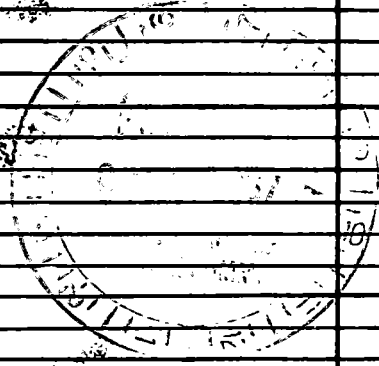

DRILLERS REMARKS:
Poor Water Sand

If well telescopes please sketch and show depths.

LOTS 45 - 48
BLK 27 GOLF + SHOP
ISLAND Dev Co. See
4/9 - 7-11

GROUND LEVEL

			X

SECTION 4

Please indicate well location X.

ADDITIONAL INFORMATION

If more than one screen,
show locations of each on sketch.