

Harrison
 L122
 10-67

MISSISSIPPI
 BOARD OF WATER COMMISSIONERS
 416 North State Street
 Jackson, Mississippi 39201

CODED

WATER WELL DRILLERS LOG

08-21-67 date well completed M&B Drilling Co. firm name Harrison county well located

LANDOWNER: B. J. Cresap
Cresote Rd
Gulfport, Miss.
 (mailing address)

WELL LOCATION:
 sec. 23 T. 7 S. R. 11 E.
1 miles N of Gulfport
 (distance) (direction) (nearest town)


WELL PURPOSE: home
 (home, irrigation, municipal, industrial)

WELL COMPLETION DATA:

- (1) diameter (inches) 2
- (2) total depth (feet) 220
- (3) static water level (feet) 0 below above top of ground.
- (4) casing PVC, 110,
 (material) (depth)
5 FT Tailpipe
 (size) if telescope see back.
- (5) screen 6 FT, 110
 (length) (depth to top)
2" PVC Filter Pac
 (size) (material)
- (6) pump 1/3 10
 (HP) (yield gpm)
220 Volt 1φ
 (type power)
- (7) electric log No
 (yes or no)
 (organization running log)
- (8) how well bottom plugged PVC Cap

description of formations encountered	from	to
Surface	0	8
White Clay	8	17
Dark Grey Clay Sandy	17	22
5 FT Dark Grey Clay	22	27
Soft light Blue Clay	27	32
Hard Green Clay	32	45
Light Grey Clay	45	55
Light Blue Clay	55	65
Grey Sand - Fine	65	100
Peat leaves & Sand	100	110
Coarse Sand	110	117
Blue Clay	117	120
		+

CODED

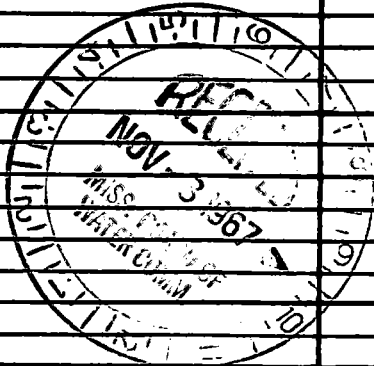

DRILLERS REMARKS:

