

Harrison  
L123  
10-67

MISSISSIPPI  
BOARD OF WATER COMMISSIONERS  
416 North State Street  
Jackson, Mississippi 39201  
WATER WELL DRILLERS LOG

**CODED**

10-26 1967 date well completed  
Switzer Shell Co. firm name  
Harrison county well located

LANDOWNER: J. Glenn Walker  
Route 1 Box 90 C  
Gulfport Miss.  
(mailing address)

WELL LOCATION:  
sec. 11 T. 7 N. R. 11 W.  
5 miles NW of GULFPORT  
(distance) (direction) (nearest town)

WELL PURPOSE: Home  
(home, irrigation, municipal, industrial)

WELL COMPLETION DATA:

- (1) diameter (inches) 2
- (2) total depth (feet) 297
- (3) static water level (feet) 23 below top of ground.
- (4) casing gal. steel 287' (material) (depth)  
2" If telescope see back. (size)
- (5) screen 10' (length), 287' (depth to top)  
8 ga. (size), SS on pipe (material)
- (6) pump 1/2 (HP), 8.5 (yield gpm)  
electric (type power)
- (7) electric log No (yes or no)  
(organization running log)
- (8) how well bottom plugged Back pressure valve

description of formations encountered	from to	
	feet	feet
clay	0	12
sand	12	31
fine clay	31	42
clay	42	63
fine sand	63	84
clay + sand streak	84	125
fine sand	125	188
fair sand	188	208
clay	208	220
sand	220	233
clay	233	269
fair sand	269	289
good sand	289	297

**CODED**


DRILLERS REMARKS:



If well telescopes please sketch and show depths.

100  
100  
100

GROUND LEVEL

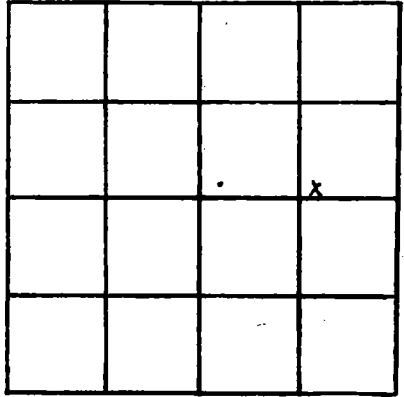

SECTION 11

Please indicate well location X.

ADDITIONAL INFORMATION

Lined area for additional information.

If more than one screen, show locations of each on sketch.