

Harrison
 L 124
 11-67

MISSISSIPPI
 BOARD OF WATER COMMISSIONERS
 416 North State Street
 Jackson, Mississippi 39201

CODED

WATER WELL DRILLERS LOG

11-24 1967 date well completed Switzer Well Co. firm name Harrison county well located

LANDOWNER: G. B. Hill
Route 3 Box 81
Gulfport, Miss.
 (mailing address)

WELL LOCATION:
 sec 21 T 7 N R 11 W
5 miles N of GULFPORT
 (distance) (direction) (nearest town)


WELL PURPOSE: Home
 (home, irrigation, municipal, industrial)

WELL COMPLETION DATA:

- (1) diameter (inches) 2
- (2) total depth (feet) 739
- (3) static water level (feet) 1 ^{below} above top of ground.
- (4) casing gal. steel, 731'
 (material) (depth)
2" if telescope see back.
 (size)
- (5) screen 8', 731'
 (length) (depth to top)
10ga, SS on pipe
 (size) (material)
- (6) pump 1/2 9
 (HP) (yield gpm)
 (type power)
- (7) electric log No
 (yes or no)
 (organization running log)
- (8) how well bottom plugged Back
pressure valve

description of formations encountered	from	to
clay	0	14
sand	14	22
sand + clay streaks	22	103
clay	103	124
fine sand	124	145
band	145	151
fine sand	151	206
band	206	216
clay	216	236
fine sand	236	246
band	246	255
clay	255	305
sand	305	320
clay	320	328
sand + clay streaks	328	348
clay	348	362
sand	362	368
sand + clay streaks	368	386
clay	386	409
sand + clay streaks	409	430
sand	430	450
fine sand	450	469
band + clay streaks	469	550
sand	550	560
clay streaks	560	570
sand + clay streaks	570	591
clay	591	614
sand	614	632
fair clay	632	635
clay	635	643
sand	643	653
clay	653	655
fair sand	655	697
good sand	697	739

CODED

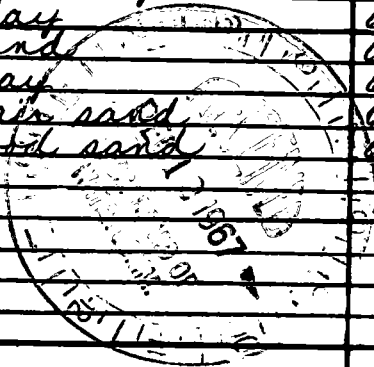

DRILLERS REMARKS:

If well telescopes please sketch and show depths.

GROUND LEVEL

	X		

SECTION 21

Please indicate well location X.

ADDITIONAL INFORMATION

If more than one screen,
show locations of each on sketch.