

Harrison
L125
12-67

MISSISSIPPI
BOARD OF WATER COMMISSIONERS
416 North State Street
Jackson, Mississippi 39201

52

WATER WELL DRILLERS LOG

CODED

12-7-67
date well completed

19 COAST WATER WELL SERVICE
firm name

Harrison
county well located

LANDOWNER: W.C. CARTER

description of formations encountered

from to

President of Gulfport Bank
at Gulfport, Miss.
(mailing address)

CLAY	0	5
FINE SAND	5	15
BLUE CLAY	15	50
COARSE SAND & GRAVEL	50	85

WELL LOCATION: NO MARK

sec. 25 T. 7 N. R. 11 E
Handsboro
miles of (distance) (direction) (nearest town)

WELL PURPOSE: Irrigation
(home, irrigation, municipal, industrial)

WELL COMPLETION DATA:

(1) diameter (inches) 2"
(2) total depth (feet) 83'
(3) static water level (feet) 10' below top of ground.

CODED


(4) casing GALV. 73' (material) (depth)
2" (size) if telescope see back.

(5) screen 10' 73' (length) (depth to top)
2" PLASTIC (size) (material)

(6) pump 1/2 (HP) 10 (yield gpm)
Elect (type power)

(7) electric log NO (yes or no)

(8) how well bottom plugged 2" BACK
WASH VALVE

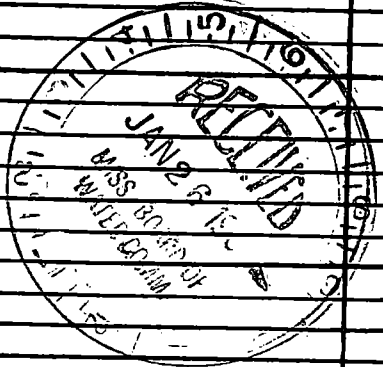

DRILLERS REMARKS:

If well telescopes please sketch and show depths.

GROUND LEVEL

		X	

SECTION 25

Please indicate well location X.

ADDITIONAL INFORMATION

If more than one screen, show locations of each on sketch.