

HARRISON
L 126
4-68

MISSISSIPPI BOARD OF WATER COMMISSIONERS

WATER WELL DRILLERS LOG

CODED

Date: 4-19, 1968, Driller: HATTIEBURG BUTLER County HARRISON
(Name)

(1) Owner of Land: Rosemary Parker
(Name)
Rt. 3 Box 234 D-1 Gulfport, Miss.
(Address)
Dog Leg Road
(2) Location: 1/4, 1/4, Sec. 9 T 75 N R 11 W
7 miles North of Gulfport
(distance) (direction) (Nearest Town)
(3) Topography: (Hilly) (Flat) (Level)
(4) Purpose of Well: Home
(Domestic Irrigation
Municipal, Industrial, Other)

Description & Color of Materials Sand, Clay, Red Clay, Shell, etc.	Thick- ness Feet	Depth Feet
<u>yellow clay</u>	<u>0</u>	<u>6</u>
<u>white sand</u>	<u>7</u>	<u>26</u>
<u>white clay</u>	<u>27</u>	<u>35</u>
<u>white sand</u>	<u>36</u>	<u>65</u>
<u>white clay</u>	<u>66</u>	<u>75</u>
<u>yellow sand</u>	<u>76</u>	<u>82</u>
<u>white clay</u>	<u>83</u>	<u>86</u>
<u>white sand</u>	<u>87</u>	<u>111</u>

Information upon completion of well:

(1) Diameter 2" inches.
(2) Total Depth 111' feet.
(3) Water Level 21' feet below top of ground.
(4) Cased to 2", Size
(5) Screen: Size 2", Length 10'
(6) Were any formations sealed against pollution?
no yes, X no.


CODED

If YES depth of formation _____
Why _____
Drillers Remarks: _____



Well No.

T. 7 S R. 11 W
Section 9

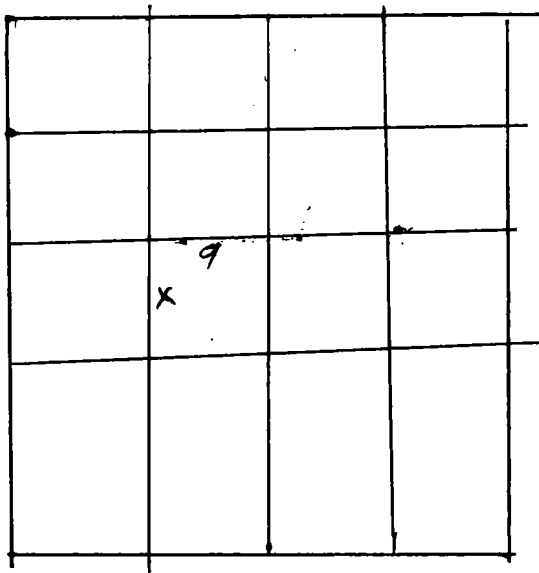

ON Dogleg Road
7 miles north of
Gulfport, Miss.
Big Green house.
East of Hwy 49.