

HARRISON
L 127
2-68

MISSISSIPPI
 BOARD OF WATER COMMISSIONERS
 416 North State Street
 Jackson, Mississippi 39201
 WATER WELL DRILLERS LOG

CODED

2-9 1968 Switzer Hall Co. Harrison
 date well completed firm name county well located

LANDOWNER: C. M. Gordon
Route 3
Robinson Road
Gulfport Miss.
 (mailing address)

WELL LOCATION:
 sec. 5 T. 7 R. 11 E
5 miles N of GULFPORT
 (distance) (direction) (nearest town)


WELL PURPOSE: SUBDIVISION
 (home, irrigation, municipal, industrial)

WELL COMPLETION DATA:

- (1) diameter (inches) 4x3 (top 24' of 4")
- (2) total depth (feet) 572
- (3) static water level (feet) 24'6" below top of ground. above
- (4) casing gal. steel 542' (material) (depth)
4x3 if telescope see back. (size)
- (5) screen 30' (length) 542' (depth to top)
8 ga. SS on pipe (size) (material)
- (6) pump 3 (HP) 50 (yield gpm)
electric (type power)
- (7) electric log No (yes or no)
 (organization running log)
- (8) how well bottom plugged Back pressure valve

description of formations encountered	from	to
clay	0	8
sand	8	20
clay	20	42
sand	42	52
clay	52	63
mixed	63	86
mixed sand	86	111
clay	111	133
mixed	133	154
clay	154	197
clay	197	219
mixed	219	241
clay	241	263
mixed	263	286
sand	286	296
clay	296	371
sand	371	395
clay	395	405
sand	405	417
clay	417	460
fine sand	460	502
sand	502	572

CODED

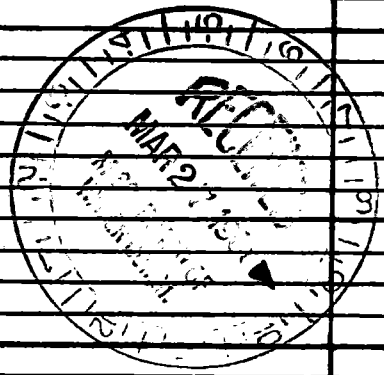

DRILLERS REMARKS:

