

Harrison
 L129
 3-68

MISSISSIPPI
 BOARD OF WATER COMMISSIONERS
 416 North State Street
 Jackson, Mississippi 39201

WATER WELL DRILLERS LOG

CODED

March 2 1968 M-43 Drilling Co. Harrison
 date well completed firm name county well located

LANDOWNER: Thomas Randolph
 Selcaut Rd. R.R.
 Culport, Miss
 (mailing address)

WELL LOCATION:
 sec. 10 T-7 S R-11 W
 4 miles N of Culport
 (distance) (direction) (nearest town)

WELL PURPOSE: Home
 (home, irrigation, municipal, industrial)


WELL COMPLETION DATA:

- (1) diameter (inches) 4 X 2
- (2) total depth (feet) 480
- (3) static water level (feet) 24 below top of ground
- (4) casing 4" PVC - 2" Galvanized Steel
 (material) (depth)
- (size) If telescope see back.
- (5) screen 10 455
 (length) (depth to top)
 2" X .008 Stainless Steel
 (size) (material)
- (6) pump 1/2 20
 (HP) (yield gpm)
 1/5 Submersible
 (type power)
- (7) electric log No
 (yes or no)
- (organization running log)
- (8) how well bottom plugged 2"
 Back Wash Valve

description of formations encountered	from	to
Surface Clay	0	15
Sand - White	15	30
Sand - Clay	30	40
Red & Yellow Clay	40	55
Grey Clay	55	60
Light Blue Clay	60	80
Grey Sand	80	120
Clay & Sand Breaker	120	300
Bla clay	300	445
Sand	445	470
Blue Clay	470	484

Circulation loss at
 400 to 435 FT.

CODED

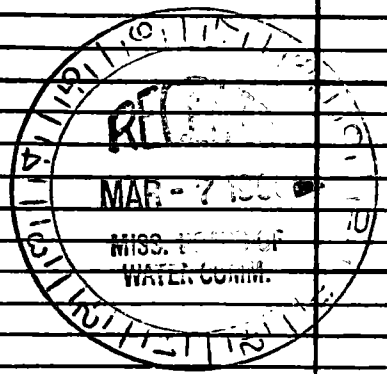

DRILLERS REMARKS:

If well telescopes please sketch and show depths.

GROUND LEVEL


44 PVC
108 FT

98 FT -
4 1/2
Nonpress
Packer
2" Galvanized
Pipe

455
2" X 10 FT. 602
S.S. Strainer
465

Tail pipe

483
- 2" B.W. Check

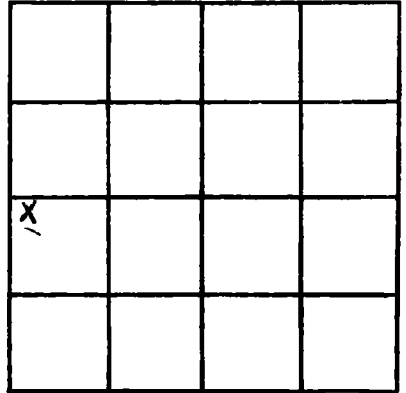

SECTION 10

Please indicate well location X.

ADDITIONAL INFORMATION

If more than one screen,
show locations of each on sketch.