

HAR.

L 134

7-23-60

WATER WELL DRILLERS LOG

CODED

308

Date: July 23, 1960, Driller: M + B Drilling Co. County Harrison

(Name)

(1) Owner of Land: Mr. George Ransey
(Name)
B.R. Bullock, Miss.
(Address)

(2) Location: 1/4, 1/4, Sec. 4 T 7 R 10
(distance) miles (direction), of (Nearest Town)

(3) Topography: Flat
(Hilly) (Flat) (Level)

(4) Purpose of Well: Domestic
(Domestic Irrigation)
Municipal, Industrial, Other)

Description & Color of Materials Sand, Clay, Red Clay, Shell, etc.	Thick- ness Feet	Depth Feet
Clay	14	14
Sand	6	20
Red Clay	22	42
White Clay	8	50
Blue Clay	13	63
Sand	33	96

Information upon completion of well:

(1) Diameter 2 inches.

(2) Total Depth 216 feet.

(3) Water Level 32 feet below top of ground.

(4) Cased to 210, Size 2"

(5) Screen: Size 8s/ft, Length 6 FT.


(6) Were any formations sealed against pollution?
 _____ yes, _____ no.

If YES depth of formation _____

Why _____

Drillers Remarks: _____

CODED

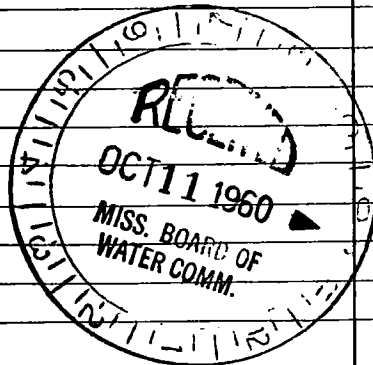

(Use Back Side)

Well No.

1910

[Faint, illegible handwritten text, possibly bleed-through from the reverse side of the page. The text is scattered across the page and includes various words and phrases that are difficult to decipher due to the low contrast and noise.]