

HAR.

MISSISSIPPI BOARD OF WATER COMMISSIONERS

L 134

8-23-60

WATER WELL DRILLERS LOG

**CODED**

Date: Aug 23, 19 60, Driller: Joe Miller

(Name)

(1) Owner of Land: J H Thompson

(Name)

Shelfort

(Address)

(2) Location: 1/4, 1/4, Sec 25 T7SR11W

         miles          of           
(distance) (direction) (Nearest Town)

(3) Topography: Flat

(Hilly) (Flat) (Level)

(4) Purpose of Well: Domestic

(Domestic Irrigation  
Municipal, Industrial, Other)

Description & Color of Materials  
Sand, Clay, Red Clay, Shell, etc.

Thick-  
ness  
Feet

Depth  
Feet

<u>Black Soil</u>	<u>5</u>	<u>5</u>
<u>White Sand Clay Br.</u>	<u>50</u>	<u>55</u>
<u>Blue Cl. small Br.</u>	<u>135</u>	<u>190</u>
<u>Thin Gray Sand</u>	<u>10</u>	<u>200</u>
<u>Sand " " Fin</u>	<u>20</u>	<u>220</u>
<u>Sand " " Sand</u>	<u>220</u>	<u>240</u>
<u>Stiller Sand</u>		

Information upon completion of well:


- (1) Diameter 2 inches.
- (2) Total Depth 242' feet.
- (3) Water Level 8' feet below top of ground.
- (4) Cased to Shelfort, Size 2"
- (5) Screen: Size 2" x 10', Length
- (6) Were any formations sealed against pollution?  
         yes,          no.

If YES depth of formation         

Why         

Drillers Remarks:         

**CODED**

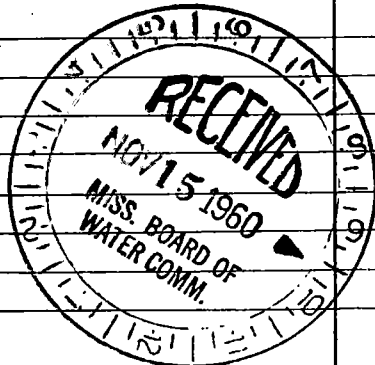

(Use Back Side)

Well No.

Duffport.

4 mi

HK4 49

3 Black.

Turkey Creek

