

HAR.

L 139
3-15-61

WATER WELL DEPTH LOG

CODED

4-311
7

Date: Mar 15, 1961, Driller: Joe Miller County: Tarrant
(Name)

- (1) Owner of Land: Leo Stufack
(Name)
RR# Sulfert, Miss
(Address)
- (2) Location: NE 1/4, NE 1/4, Sec. 29 T7R11
2 miles North of Sulfert
(distance) (direction) (Nearest Town)
- (3) Topography: Flat
(Hilly) (Flat) (Level)
- (4) Purpose of Well: Home + Gourd
(Domestic Irrigation) (Municipal, Industrial) (Other)

Description & Color of Materials Sand, Clay, Red Clay, Shell, etc.	Thick- ness Feet	Depth Feet
Surface	3	3
Wh. Cl.	5	8
Wh. Sand.	13	21
Blu Cl. Small Pe.	99	120
Sand Blu. Fine	9	129
Blu Cl. Fairly Hd.	25	154
Blu sd. Fine	33	187
Bl sd. Fair	10	197
Blu sd. Good	12	209
Hd Blu Cl.	2	211

Information upon completion of well:

- (1) Diameter: 2 inches.
- (2) Total Depth: 211 feet.
- (3) Water Level: Flowing feet below top of ground.
- (4) Cased to: 199, Size 2"
- (5) Screen: Size 2", Length 10'
- (6) Were any formations sealed against pollution?
yes, no.


CODED

If YES depth of formation _____

Why _____

Drillers Remarks: _____

Pumped 2000 G.P.H
By Air

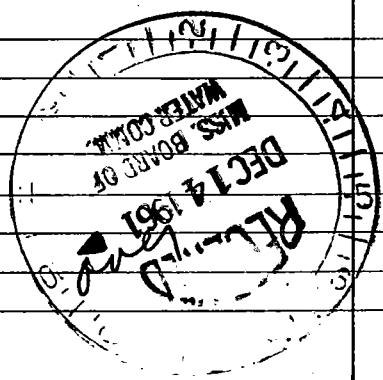

(Use Back Side)

Well No.

Gulfport Miss

New Rky 49

old Rky 49

Jurber Creek

well

Landon Rd,

