

HARRISON  
L 104

MISSISSIPPI BOARD OF WATER COMMISSIONERS

WATER WELL DRILLERS LOG

7  
**CODED**

11-11-60

Date: Nov 11, 1960, Driller: J. Beed County Lamar

(Name)

(1) Owner of Land: E. L. Kelley

(Name)

(Address)

(2) Location: 1/4, 1/4, Sec. 32 T. R.

1 miles west, of Nugent  
(distance) (direction) (Nearest Town)

(3) Topography: X  
(Hilly) (Flat) (Level)

(4) Purpose of Well: Home use  
(Domestic Irrigation  
Municipal, Industrial, Other)

Information upon completion of well:

(1) Diameter 2 1/4" inches.

(2) Total Depth 548 feet.

(3) Water Level 30 feet below top of ground.

(4) Cased to \_\_\_\_\_, Size \_\_\_\_\_

(5) Screen: Size 1 1/4", Length 10'

(6) Were any formations sealed against pollution?

\_\_\_\_\_ yes, \_\_\_\_\_ no.

If YES depth of formation \_\_\_\_\_

Why \_\_\_\_\_

Drillers Remarks: \_\_\_\_\_

Description & Color of Materials  
Sand, Clay, Red Clay, Shell, etc.

Thick-  
ness  
Feet

Depth  
Feet

21 ft Red Clay

21

63 Red Sand

63

220 sand fine

2

20

Hard Blue Clay to

2

83

Small fine sand

17

Red Hard Clay


✓

00

Stratton

48

**CODED**

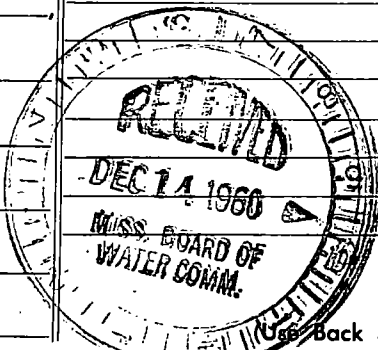

Well No.

Mail this copy to Board of Water Commissioners 429 Miss. St. Jackson, Miss.

