

Harrison
 L178
 4-67

MISSISSIPPI
 BOARD OF WATER COMMISSIONERS
 416 North State Street
 Jackson, Mississippi 39201


WATER WELL DRILLERS LOG

CODED

4-17 1967 Switzer Well Co. Harrison
 date well completed firm name county well located


LANDOWNER:	description of formations encountered	from	to
Sherwood Bailey	clay	0	35
8 Poplar Circle	sand	35	74
Gulfport, Miss.	clay	74	123
(mailing address)	sand	123	137
WELL LOCATION:	clay	137	174
sec. 25 T 7 S R 11 E W	sand	174	184
_____ miles of _____ of _____	fine sand	184	226
(distance) (direction) (nearest town)	sand	226	240
WELL PURPOSE:	clay	240	430
(home, irrigation, municipal, industrial)	sand	430	486
WELL COMPLETION DATA:	clay	486	505
(1) diameter (inches) 2 x 4	sand	505	528
(2) total depth (feet) 654	clay	528	565
(3) static water level (feet) 4 below top of ground.	sand	565	572
(4) casing gal steel, 644' (material) (depth)	good sand	572	654
2 x 4 (size) if telescope see back.			
(5) screen 30' (length) 624' (depth to top)			
8 ga, SS on pipe (size) (material)			
(6) pump 2 (HP) 40 (yield gpm)			
electric (type power)			
(7) electric log No (yes or no)			
(organization running log)			
(8) how well bottom plugged Back pressure valve			
DRILLERS REMARKS:			

CODED

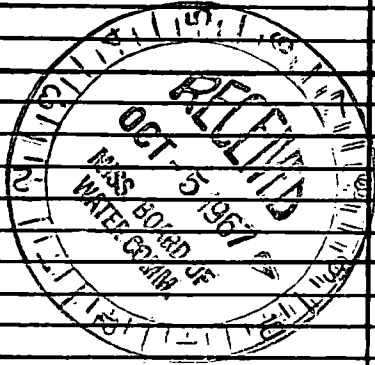

If well telescopes please sketch and show depths.

GROUND LEVEL

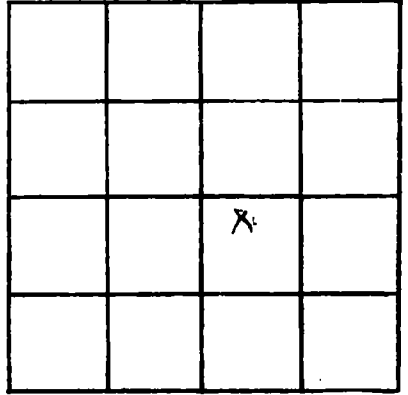

SECTION 25

Please indicate well location X.

ADDITIONAL INFORMATION

Lined area for additional information.

If more than one screen, show locations of each on sketch.