

Harrison
 L #180
 7-68

MISSISSIPPI
 BOARD OF WATER COMMISSIONERS
 416 North State Street
 Jackson, Mississippi 39201

CODED

WATER WELL DRILLERS LOG

2-28 date well completed
 R.P.J. Moore firm name
 HARRISON county well located

LANDOWNER: MRS. Doris Stewart
 RT. 1 Box 87
 GULFPORT, MISS. 39501
 (mailing address)

description of formations encountered	depth	
	from	to
SURFACE SOIL	0	12
RUSTY SAND	12	20
WHITE + Red CHAY +	20	
BLUE CHAY		50
COARSE RUSTY SAND	50	90
BLUE CHAY	90	200
BLUE SAND (GOOD)	200	220
BLUE CHAY	220	560
BLUE SAND (COARSE)	560	603

WELL LOCATION:
 sec. 11 T 7 N R 11 E
 5 miles EAST of ORANGE GROVE
 (distance) (direction) (nearest town)

WELL PURPOSE: Home
 (home, irrigation, municipal, industrial)

WELL COMPLETION DATA:

- (1) diameter (inches) 2"
- (2) total depth (feet) 603'
- (3) static water level (feet) 32' ^{below}/_{above} top of ground.
- (4) casing 2" GALV 5'84"
 (material) (depth)
- _____ If telescope see back.
 (size)
- (5) screen 10' 5'84"
 (length) (depth to top)
2" SS
 (size) (material)
- (6) pump 1/2 7
 (HP) (yield gpm)
ELec
 (type power)
- (7) electric log (yes or no)

 (organization running log)
- (8) how well bottom plugged BACK
WASH VALVE

CODED


AUG 13 1968

MISS. BD. OF
 WATER COMM.

DRILLERS REMARKS: DID NOT
 DRILL THROUGH SAND

If well telescopes please sketch and show depths.

GROUND LEVEL

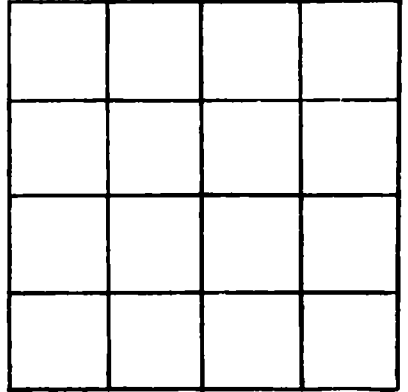

SECTION _____

Please indicate well location X.

ADDITIONAL INFORMATION

If more than one screen, show locations of each on sketch.