

and different
well

Harrison
L 181 CODED
7-68

MISSISSIPPI
BOARD OF WATER COMMISSIONERS
416 North State Street
Jackson, Mississippi 39201

CODED

WATER WELL DRILLERS LOG

7-19 1968 C. J. Switzer Well Co Harrison
date well completed firm name county well located

LANDOWNER John Tomlinson

Route 3 Box 50
Melfort Miss.
(mailing address)

WELL LOCATION:

sec. 24 T. 2 S. R. 11 W.
2 miles N of HANDBORO
(distance) (direction) (nearest town)

WELL PURPOSE: Home
(home, irrigation, municipal, industrial)

WELL COMPLETION DATA:

- (1) diameter (inches) 3 x 2
- (2) total depth (feet) 340
- (3) static water level (feet) 18 below top of ground.
- (4) casing gal steel, 320' (material) (depth)
3 x 2 (size) If telescope see back.
- (5) screen 20' (length), 320' (depth to top)
8 ga. SS on pipe (size) (material)
- (6) pump 1 (HP), 350 gpm (yield gpm)
electric (type power)
- (7) electric log No (yes or no)


(organization running log)

(8) how well bottom plugged Back pressure valve

DRILLERS REMARKS:

| description of formations encountered | from to | |
|---------------------------------------|---------|-----|
| | | |
| clay | 0 | 21 |
| sand | 21 | 31 |
| clay | 31 | 43 |
| sand | 43 | 87 |
| mixed | 87 | 148 |
| clay | 148 | 186 |
| mixed | 186 | 192 |
| clay | 192 | 282 |
| mixed | 282 | 304 |
| clay | 304 | 308 |
| sand | 308 | 340 |

CODED

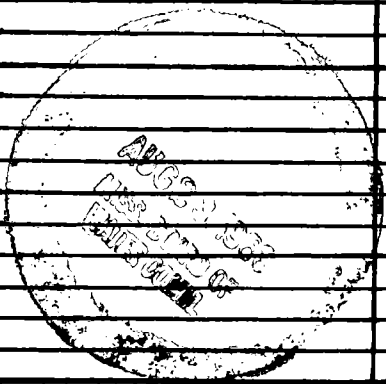

If well telescopes please sketch and show depths.

GROUND LEVEL

| | | | |
|--|--|--|--|
| | | | |
| | | | |
| | | | |
| | | | |

SECTION 24

Please indicate well location X.

ADDITIONAL INFORMATION

If more than one screen, show locations of each on sketch.