

Harrison  
 L 182 **CODED**  
 9-9-68

MISSISSIPPI  
 BOARD OF WATER COMMISSIONERS  
 416 North State Street  
 Jackson, Mississippi 39201

**CODED**

WATER WELL DRILLERS LOG

9-9 19 68 Hattiesburg Bitane HARRISON  
 date well completed firm name county well located

LANDOWNER: O. L. MORAN

Rt. 1  
Gulfport, Miss.  
 (mailing address)

WELL LOCATION:

sec. 9 T. 7 S. R. 11 W.  
7 miles North of Gulfport.  
 (distance) (direction) (nearest town)


WELL PURPOSE: home  
 (home, irrigation, municipal, industrial)

WELL COMPLETION DATA:

- (1) diameter (inches) 2"
- (2) total depth (feet) 355'
- (3) static water level (feet) 10 below top of ground.
- (4) casing Galv. 355'  
 (material) (depth)
- 2" if telescope see back.  
 (size)
- (5) screen 10' 355'  
 (length) (depth to top)
- 2" BRONZE  
 (size) (material)
- (6) pump 1 575  
 (HP) (yield gpm)
- electric  
 (type power)
- (7) electric log NO  
 (yes or no)
- NO  
 (organization running log)
- (8) how well bottom plugged BACK WASH VALVE

description of formations encountered	from to	
gray sand	0	5
yellow sand	6	10
white sand	11	12
yellow clay	13	19
white clay	20	30
black clay	31	42
yellow clay	43	57
white clay	58	70
white sand	71	90
white clay	91	92
white sand	93	101
white clay	102	109
black clay + black sand	110	158
black clay	159	167
black clay + black sand	168	200
white sand	201	209
black clay + black sand	210	340
black sand	341	355

**CODED**

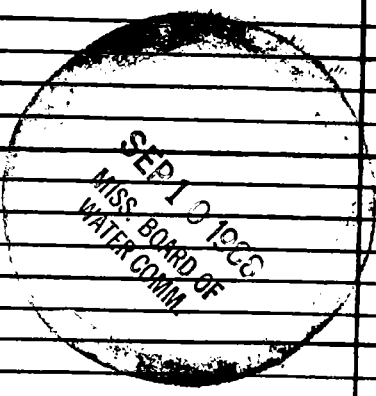

DRILLERS REMARKS:

If well telescopes please sketch and show depths.

GROUND LEVEL

	X		

SECTION 9

Please indicate well location X.

ADDITIONAL INFORMATION

on Red Sea Road approx.  
7 miles N. of H. of H.  
Road to Hwy 119.

If more than one screen, show locations of each on sketch.