

Harrison  
 L 183 CODED  
 9-10-68

MISSISSIPPI  
 BOARD OF WATER COMMISSIONERS  
 416 North State Street  
 Jackson, Mississippi 39201

**CODED**

WATER WELL DRILLERS LOG

9-10-68 19 HATTIESBURG Butane HARRISON  
 date well completed firm name county well located

LANDOWNER: Leon Lewis

2313 16<sup>th</sup> Avenue  
 Gulfport, Miss.  
 (mailing address)

WELL LOCATION:

sec 8 T 7<sup>S</sup> R 11<sup>E</sup>  
 2 1/2 miles NW of Gulfport  
 (distance) (direction) (nearest town)

WELL PURPOSE: home  
 (home, irrigation, municipal, industrial)


WELL COMPLETION DATA:

- (1) diameter (inches) 2"
- (2) total depth (feet) 198'
- (3) static water level (feet) 10' below top of ground.
- (4) casing galv. 198'  
 (material) (depth)
- 2" if telescope see back  
 (size) 198'
- (5) screen 10' BRONZE  
 (length) (depth to top)
- 2" BRONZE  
 (size) (material)
- (6) pump 1 600  
 (HP) (yield gpm)
- electric  
 (type power)
- (7) electric log NO  
 (yes or no)
- NO  
 (organization running log)
- (8) how well bottom plugged  
 BACK WASH VALVE

description of formations encountered

	from	to
yellow clay	0	5
white sand	6	8
yellow sand	9	12
white sand	13	23
white clay	24	30
white sand & black sand	31	85
black clay	86	128
black sand	129	198

**CODED**

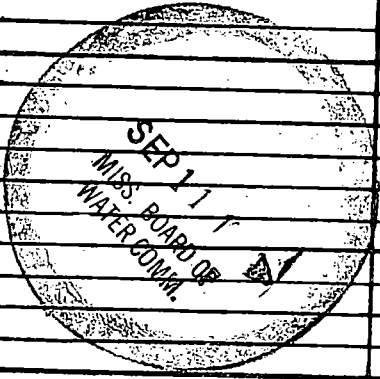

DRILLERS REMARKS:

If well telescopes please sketch and show depths.

GROUND LEVEL

	X		

SECTION 8

Please indicate well location X.

ADDITIONAL INFORMATION

Calverton Road - Turn  
right off Linden Road  
1/2 mile to left Malco  
NW of Lot.

If more than one screen,  
show locations of each on sketch.