

Harrison
 L187
 11-6-68

MISSISSIPPI
 BOARD OF WATER COMMISSIONERS
 416 North State Street
 Jackson, Mississippi 39201

CODED

WATER WELL DRILLERS LOG

Nov 6 1968 H & B Drilling Co. Harrison
 date well completed firm name county well located

LANDOWNER: Kenneth Layton
 Northwood Hills Subdivision
 A-way 49, Cutfoot
 (mailing address)

description of formations encountered	from	to
Surface	0	7
White Sand	7	30
White Sand & Small Gravel	30	62
White Clay	62	100
	+	

WELL LOCATION:
 sec. 4 T. 7 S. R. 11 E.
 5 miles N of Cutfoot
 (distance) (direction) (nearest town)

WELL PURPOSE: Lake
 (home, irrigation, municipal, industrial)

WELL COMPLETION DATA:

- (1) diameter (Inches) 4"
- (2) total depth (feet) 62
- (3) static water level (feet) 5 below top of ground.
- (4) casing Steel 62 (material), (depth), 4" (size) if telescope see back.
- (5) screen 20 (length), 62 (depth to top), 3" (size), S.S., 010 (material)
- (6) pump 3 (HP), 80 (yield gpm), 220 1/2 (type power), Burke Submer. Turbine
- (7) electric log No (yes or no)

CODED

(organization running log)

(8) how well bottom plugged
 3" Back Wash Valve


DRILLERS REMARKS:

DEC 10 1968

MISS. BD. OF WATER COMM.

If well telescopes please sketch and show depths.

GROUND LEVEL

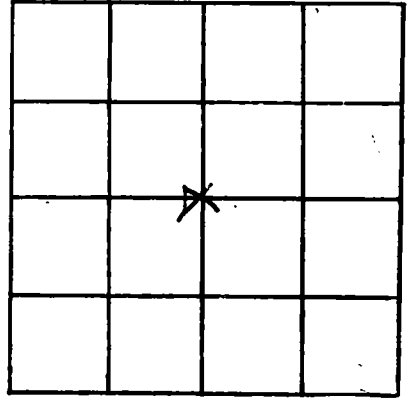

SECTION 4

Please indicate well location X.

ADDITIONAL INFORMATION

If more than one screen, show locations of each on sketch.