

Harrison
 L 188
 11-28-68

MISSISSIPPI
 BOARD OF WATER COMMISSIONERS
 416 North State Street
 Jackson, Mississippi 39201

CODER

WATER WELL DRILLERS LOG

Nov. 28 1968 M & B Drilling Co. Harrison
 date well completed firm name county well located

LANDOWNER: Humble Oil Co.
 Highway 49 & Deleaux Rd
 Gulfport, Miss.
 (mailing address)

WELL LOCATION:
 sec. 9 T. 7 S. R. 11 W.
 1/2 miles N of Leadon
 (distance) (direction) (nearest town)

WELL PURPOSE: Service Station
 (home, irrigation, municipal, industrial)

WELL COMPLETION DATA:

- (1) diameter (inches) 4 X 2
- (2) total depth (feet) 400
- (3) static water level (feet) 116 below top of ground.
- (4) casing Galv. Steel 390 (material) (depth)
- 4 X 2 if telescope see back. (size)
- (5) screen 10 (length) 390 (depth to top)
2" (size) Stainless Steel (material)
- (6) pump 1 (HP) 25 (yield gpm)
220 V 1/2 (type power) Burks Submers. Set 63 FT.
- (7) electric log No (yes or no)
- (organization running log)
- (8) how well bottom plugged 2" Beck Wash Valve

description of formations encountered	from	to
Surface Clay	0	20
White Sand	20	35
White Clay	35	55
Blue Clay	55	75
White Clay & Brown Sand	75	120
Blue Clay	120	160
Dark Grey Clay	160	190
Dark Grey Clay	160	190
Sand	190	210
Blue Clay	210	310
Fine Sand	310	320
Blue Clay	320	345
Medium Sand	345	363
Blue Clay	363	375
Medium Sand	375	400
Blue Clay	400	410
Sand & Clay Breaks	410	440
Blue Clay	440	450
CODER		
Still Casing Clay		450



DRILLERS REMARKS:

DEC 10 1968

MISS. RD. COM.
 WATER COMMISSIONERS

If well telescopes please sketch and show depths.

GROUND LEVEL

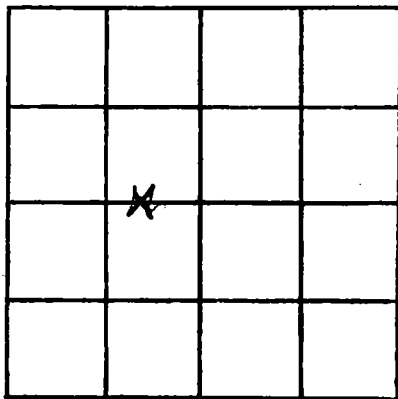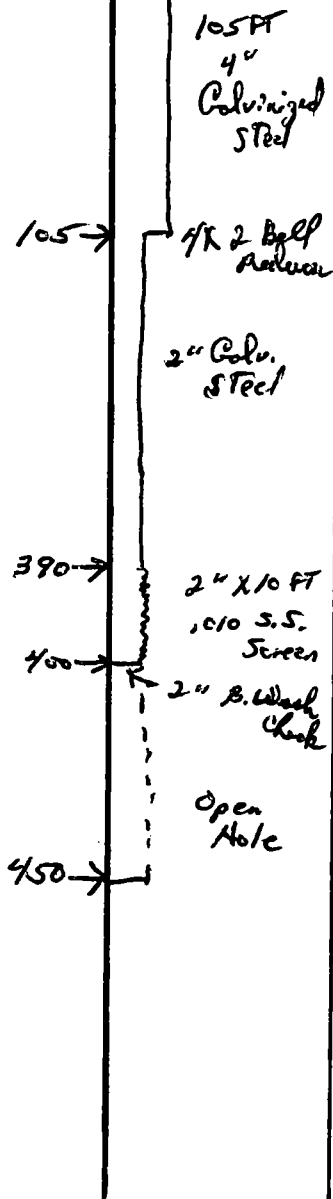

SECTION 9

Please indicate well location X.

ADDITIONAL INFORMATION

If more than one screen, show locations of each on sketch.