

Harrison
 L 189
 9-10-68

MISSISSIPPI
 BOARD OF WATER COMMISSIONERS
 416 North State Street
 Jackson, Mississippi 39201

CODED

WATER WELL DRILLERS LOG

9-10 date well completed 1968 McB Drilling Co. firm name Harrison county well located

LANDOWNER: Albert Walter
Herring Rd. - R.R.
Osbert, Miss.
 (mailing address)

WELL LOCATION:
 sec. 5 T 7 S R 11 W
2 1/2 miles (distance) S (direction) of Lyman (nearest town)

WELL PURPOSE: None
 (home, irrigation, municipal, industrial)

WELL COMPLETION DATA:

- (1) diameter (inches) 2
- (2) total depth (feet) 500
- (3) static water level (feet) 31 below above top of ground.
- (4) casing Pvc (material) Total (depth)
- 2 1/2 (size) If telescope see back.
- (5) screen 9 FT (length) 480 (depth to top)
- 2 1/2 (size) Pvc Sand Pac (material)
- (6) pump 1/2 (HP) 10 (yield gpm)
- 115 1/2 (type power) 4 FT Tail Pipe
- (7) electric log No (yes or no)

(organization running log)

(8) how well bottom plugged 2 1/2 Pvc Cap

DRILLERS REMARKS:

description of formations encountered	from	to
Surface Clay	0	12
Sand	12	15
Yellow Clay	15	17
White Clay	17	22
Blue Clay	22	40
Tan Clay	40	50
White Clay	50	85
Blue Clay	85	100
Sand & Clay Breaks	100	110
Blue Clay	110	130
Fine Sand & Dark Grey Clay	130	160
Dark Grey Clay	160	190
Soft Blue Clay	190	292
Fine Sand	292	299
Blue Clay	299	405
Fine Sand	405	415
Blue Clay	415	445
Good Sand	445	500
Still cutting sand at 500		
Circulation Loss	340	405


CODED

DEC 10 1968

MISS. BD. OF WATER COMM.

If well telescopes please sketch and show depths.

GROUND LEVEL

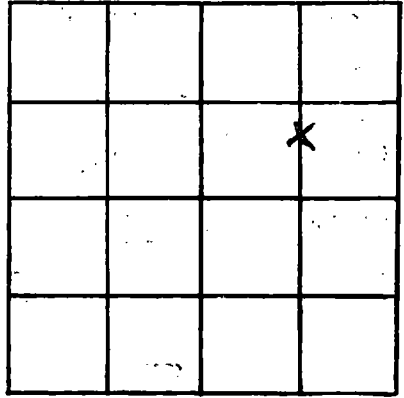

SECTION 5

Please indicate well location X.

ADDITIONAL INFORMATION

If more than one screen, show locations of each on sketch.