

HARRISON  
 L 190  
 10-30-68

MISSISSIPPI  
 BOARD OF WATER COMMISSIONERS  
 416 North State Street  
 Jackson, Mississippi 39201

**CODED**

WATER WELL DRILLERS LOG

Oct. 30 1968 Mc B Drilling Co. Harrison  
 date well completed firm name county well located

LANDOWNER: Sue Laker  
 Highway 49 R.R.  
 Culport, Miss.  
 (mailing address)

WELL LOCATION:  
 sec. 9 T. 6 S R. 11 W  
 2 miles N of Lumberton  
 (distance) (direction) (nearest town)

WELL PURPOSE: Home  
 (home, irrigation, municipal, industrial)

WELL COMPLETION DATA:

- (1) diameter (inches) 2
- (2) total depth (feet) 455
- (3) static water level (feet) 30 below top of ground.
- (4) casing PK (material), Total (depth), 2" (size) if telescope see back.
- (5) screen 9 FT. (length), 441 (depth to top), 2" (size), PVC Sand Pac (material)
- (6) pump 1 (HP), 12 (yield gpm), 1/0 1/2 (type power)
- (7) electric log No. (yes or no)  
 (organization running log)
- (8) how well bottom plugged 2" PVC Cap

description of formations encountered	from	to
Surface Clay	0	17
Sandy Gravel	17	34
White Clay	34	50
White & Red Clay	50	70
White Clay	70	80
White Clay & Sand & Gravel	80	100
Pink Clay	100	105
White Clay	105	115
Blue Clay	115	137
Dark Gray Clay & Fine Sand	137	160
Dark Green Clay	160	192
Blue Clay	192	215
Rock Ledge	215	217
Blue Clay	217	364
Sand	364	372
Blue Clay	372	405
Sand	405	452
Blue Clay	452	455
		+

**CODED**


DEC 1 1968

MISS. BD. OF WATER COMM.

DRILLERS REMARKS:

If well telescopes please sketch and show depths.

GROUND LEVEL

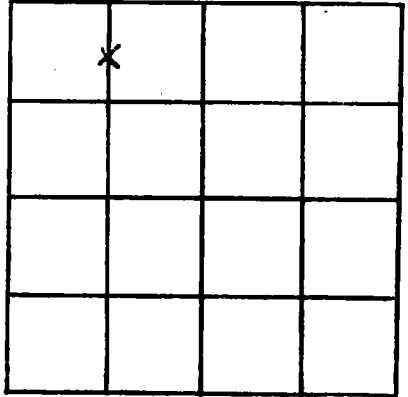

SECTION 9

Please indicate well location X.

ADDITIONAL INFORMATION

If more than one screen, show locations of each on sketch.