

Harrison  
L 195  
1-14-69

MISSISSIPPI  
 BOARD OF WATER COMMISSIONERS  
 416 North State Street  
 Jackson, Mississippi 39201

**CODED**

WATER WELL DRILLERS LOG

1-14-69 19 R. J. Moore HARRISON  
 date well completed firm name county well located

LANDOWNER: Jimmy Dearman  
RT #1 GULSPORT  
 (mailing address)  
 WELL LOCATION:  
 sec. 6 T. 7 N. R. 11 E  
2 miles W of NUREXT  
 (distance) (direction) (nearest town)

description of formations encountered	from	to
TOP SOIL	0	12
SURFACE SAND	12	20
BLUE CHAY	20	104
WHITE PUSY SAND	104	125
BLUE CHAY	125	219
BLUE SAND	219	250

WELL PURPOSE:  
 (home) Irrigation, municipal, industrial

WELL COMPLETION DATA:  
 (1) diameter (inches) 2"  
 (2) total depth (feet) 251  
 (3) static water level (feet) 32  below above top of ground.  
 (4) casing 2 1/2" GALV 219  
 (material) (depth)  
 (size) if telescope see back.  
 (5) screen 2" 219  
 (length) (depth to top)  
2" S.S.  
 (size) (material)  
 (6) pump — —  
 (HP) (yield gpm)  
 (type power)  
 (7) electric log yes or no  
 (organization running log)  
 (8) how well bottom plugged B.W. GALV

**CODED**


FEB 28 1969

MISS. Bd. of  
 WATER COMMISSIONERS

DRILLERS REMARKS:

If well telescopes please sketch and show depths.

GROUND LEVEL

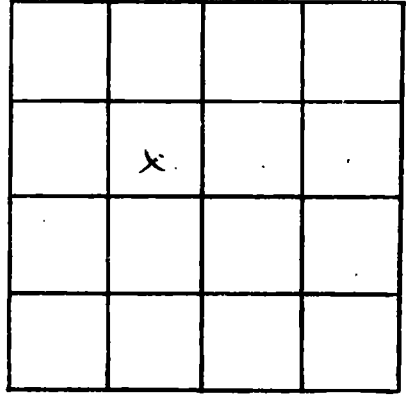

SECTION 6

Please indicate well location X.

ADDITIONAL INFORMATION

If more than one screen,  
show locations of each on sketch.