

Harrison  
L 196  
1-20-69

MISSISSIPPI  
BOARD OF WATER COMMISSIONERS  
416 North State Street  
Jackson, Mississippi 39201

**CODED**

WATER WELL DRILLERS LOG

1-20-69 19 R J Mooka HARRISON  
date well completed firm name county well located


LANDOWNER:	description of formations encountered	from	to
<u>EARL STIGLITS</u> <u>ROBISON RD RT#1</u> <u>GULFPORT, MISS</u> (mailing address)			
<b>WELL LOCATION:</b> sec <u>S T 2 N</u> R <u>11 E</u> (distance) (direction) (nearest town)	<u>WHITE SAND</u>	<u>10</u>	<u>14</u>
<b>WELL PURPOSE:</b> (home) irrigation, municipal, industrial	<u>Blue Clay</u>	<u>14</u>	<u>93</u>
<b>WELL COMPLETION DATA:</b>	<u>White Rusty Sand</u>	<u>93</u>	<u>104</u>
(1) diameter (inches) <u>2"</u>	<u>Blue Clay</u>	<u>104</u>	<u>180</u>
(2) total depth (feet) <u>240</u>	<u>Blue Sand</u>	<u>180</u>	<u>219</u>
(3) static water level (feet) <u>30</u> <u>below</u> above top of ground.	<u>Blue Clay</u>	<u>219</u>	<u>240</u>
(4) casing <u>Galv</u> <u>190'</u> (material) (depth)			
_____ if telescope see back. (size)			
(5) screen <u>10'</u> <u>190'</u> (length) (depth to top)			
<u>2</u> <u>S.S.</u> (size) (material)			
(6) pump <u>1</u> <u>490</u> (HP) (yield gpm)			
<u>Fluo</u> (type power)			
(7) electric log (yes or no) _____ (organization running log)			
(8) how well bottom plugged <u>B.W. with lead</u>			
<b>DRILLERS REMARKS:</b>			

**CODED**

FEB 20 1969  
MISS. Bd. of WATER COMMISSIONERS

If well telescopes please sketch and show depths.

GROUND LEVEL

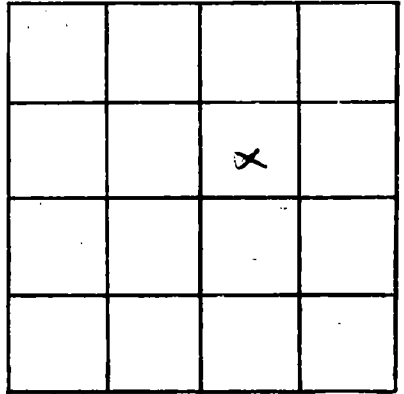

SECTION 5

Please indicate well location X.

ADDITIONAL INFORMATION

If more than one screen, show locations of each on sketch.