

HAR.  
L202  
5-25-61

WATER WELL DRILLERS LOG **CODED**

Date: May 25, 1961, Driller: C. T. SWITZER WELL CO. County Harrison

(Name)

(1) Owner of Land: J. A. Dedaux  
(Name)

RT # 1 Box 328  
(Address)

(2) Location: 6 7 11  
1/4, 1/4, Sec. T R

         miles         , of           
(distance) (direction) (Nearest Town)

(3) Topography: X  
(Hilly) (Flat) (Level)

(4) Purpose of Well: Domestic  
(Domestic Irrigation  
Municipal, Industrial, Other)

Description & Color of Materials Sand, Clay, Red Clay, Shell, etc.	Thick- ness Feet	Depth Feet
<u>Clay</u>	<u>6</u>	<u>14</u>
<u>sand</u>	<u>14</u>	<u>24</u>
<u>clay</u>	<u>24</u>	<u>80</u>
<u>sand</u>	<u>80</u>	<u>101</u>

Information upon completion of well:

(1) Diameter 2" inches.

(2) Total Depth 101 feet.

(3) Water Level 2' feet below top of ground.

(4) Cased to 101, Size 2"

(5) Screen: Size 2", Length 10'


(6) Were any formations sealed against pollution?  
X yes,          no.

If YES depth of formation         

Why Health Dept Requirement

Drillers Remarks:         

**CODED**

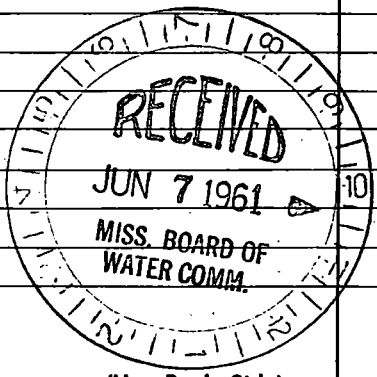

(Use Back Side)

Well No.

