

896. 4662
864-355

CODED

Harrison
L204
7-17-68

MISSISSIPPI
BOARD OF WATER COMMISSIONERS
416 North State Street
Jackson, Mississippi 39201

WATER WELL DRILLERS LOG

7-17 1968 Sutter Well Works Harrison
date well completed firm name county well located

LANDOWNER: Collins Bedy Jr
Sumkey H Project
Biloxi, Miss.

| Description of formations encountered | from | to |
|---------------------------------------|------------|------------|
| <u>Clay</u> | <u>0</u> | <u>18</u> |
| <u>Sand</u> | <u>18</u> | <u>47</u> |
| <u>Clay-sand streaks</u> | <u>47</u> | <u>210</u> |
| <u>Sand</u> | <u>210</u> | <u>230</u> |
| <u>Clay</u> | <u>230</u> | <u>360</u> |
| <u>Sand</u> | <u>360</u> | <u>392</u> |
| <u>Clay-sand streaks</u> | <u>392</u> | <u>686</u> |
| <u>Sand</u> | <u>686</u> | <u>794</u> |

(mailing address)

WELL LOCATION:
sec. 21 T. 2 S. R. 11 E. W. 5
1 miles N of Gulfport
(distance) (direction) (nearest town)

WELL PURPOSE: Sub-irrigation
(home, irrigation, municipal, industrial)

WELL COMPLETION DATA:


- (1) diameter (inches) 4x6
- (2) total depth (feet) 794
- (3) static water level (feet) 15 below top of ground.
- (4) casing hel steel 734'
(material) (depth)
- 4"x6"
(size) If telescope see back.
- (5) screen 60' 734'
(length) (depth to top)
- 4" stainless steel
(size) (material)
- (6) pump 10 150
(HP) (yield gpm)
- elec.
(type power)
- (7) electric log no
(yes or no)

CODED

(organization running log)


(8) how well bottom plugged B.P. Value

DRILLERS REMARKS: Upper 6"
Casing Cemented

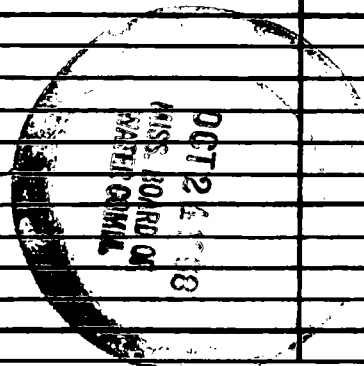

If well telescopes please sketch and show depths.

GROUND LEVEL

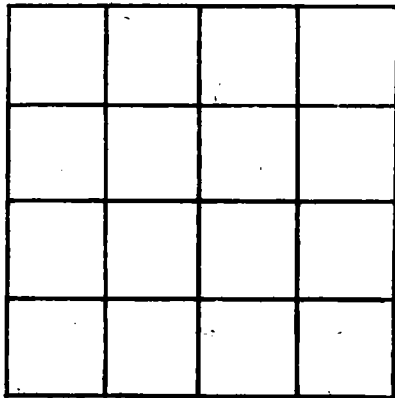

SECTION _____

Please indicate well location X.

ADDITIONAL INFORMATION

If more than one screen, show locations of each on sketch.