

**CODED**

Harrison  
L-206  
9-11-68

MISSISSIPPI  
BOARD OF WATER COMMISSIONERS  
416 North State Street  
Jackson, Mississippi 39201

WATER WELL DRILLERS LOG

9-11 1968 date well completed  
Dutter Well Works firm name  
Harrison county well located

LANDOWNER: RD Hunt

Rt 1 Box 428

Gulfport  
(mailing address)

WELL LOCATION:  
sec. 18 T. 7 N. R. 11 E.  
S W

\_\_\_\_\_ miles \_\_\_\_\_ of \_\_\_\_\_  
(distance) (direction) (nearest town)

WELL PURPOSE: home  
(home, irrigation, municipal, industrial)

WELL COMPLETION DATA:

(1) diameter (inches) 2

(2) total depth (feet) 215

(3) static water level (feet) 24 below  
top of ground. above

(4) casing Galv. 210'  
(material) (depth)

2"  
(size) if telescope see back.

(5) screen 5' 210'  
(length) (depth to top)

2' Stainless Steel  
(size) (material)

(6) pump \_\_\_\_\_ (HP) \_\_\_\_\_ (yield gpm)

(type power)


(7) electric log no  
(yes or no)

(organization running log)

(8) how well bottom plugged BP value

description of formations encountered	from	to
Clay	0	18
Sand	18	46
Clay	46	82
Sand	82	107
Clay	107	155
Sand	155	215

**CODED**

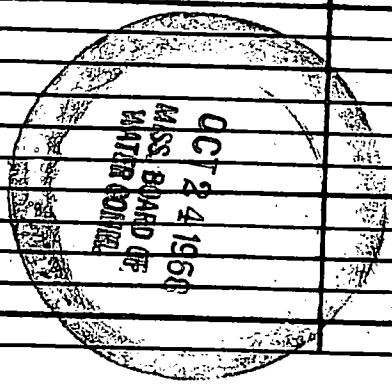

DRILLERS REMARKS:

If well telescopes please sketch and show depths.

GROUND LEVEL


SECTION \_\_\_\_\_

Please indicate well location X.

ADDITIONAL INFORMATION

If more than one screen, show locations of each on sketch.