

CODED

MISSISSIPPI
BOARD OF WATER COMMISSIONERS
416 North State Street
Jackson, Mississippi 39201

WATER WELL DRILLERS LOG

Harrison
L-207
11-1-68

11-1 19 68 Little Well Works Harrison
date well completed firm name county well located

LANDOWNER: Jack Ballard

description of formations encountered	from to	
	feet	feet
<u>sand</u>	<u>0</u>	<u>30</u>
<u>clay</u>	<u>30</u>	<u>50</u>
<u>sand</u>	<u>50</u>	<u>68</u>

Gulfport, Miss.
(mailing address)

WELL LOCATION:
sec. 27 T-8 N R-11 E
S W
1/4 of 1/4 1/4
miles (distance) IN (direction) of (nearest town)


WELL PURPOSE: for Cordonis
(home, irrigation, municipal, industrial)

WELL COMPLETION DATA:

- (1) diameter (inches) 2
- (2) total depth (feet) 68
- (3) static water level (feet) 15 below above top of ground.
- (4) casing galv. 63'
(material) (depth)
- 2"
(size) if telescope see back.
- (5) screen 5' 63'
(length) (depth to top)
- 2" Stainless Steel
(size) (material)
- (6) pump unknown
(HP) (yield gpm)
- (type power)
- (7) electric log no
(yes or no)
- (organization running log)
- (8) how well bottom plugged BP Valve

CODED

DRILLERS REMARKS:

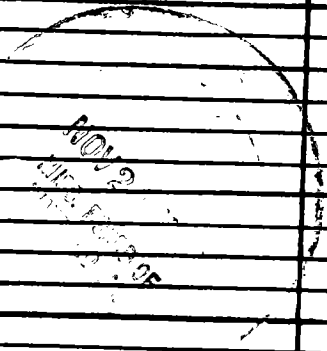

If well telescopes please sketch and show depths.

GROUND LEVEL

SECTION _____
Please indicate well location X.

ADDITIONAL INFORMATION

If more than one screen, show locations of each on sketch.