

Harrison
L209
12-13-68

MISSISSIPPI
BOARD OF WATER COMMISSIONERS
416 North State Street
Jackson, Mississippi 39201

CODED

WATER WELL DRILLERS LOG

Dec. 13 1968 Ladner's Drilling Harrison
date well completed firm name county well located

LANDOWNER: H. W. Boeman
Landon Miss
(mailing address)

description of formations encountered	from	to
<u>yellow clay</u>	<u>20 feet</u>	
<u>sand</u>	<u>80 feet</u>	
<u>blue clay</u>	<u>70 feet</u>	
<u>blue sand</u>	<u>40 feet</u>	

WELL LOCATION:
sec. 17 T. 7 S. R. 11 W.
1/2 miles West of Landon
(distance) (direction) (nearest town)

WELL PURPOSE: home
(home, irrigation, municipal, industrial)

- WELL COMPLETION DATA:
- (1) diameter (inches) 2 inch
 - (2) total depth (feet) 210
 - (3) static water level (feet) 5 below top of ground.
 - (4) casing gal. (material), 200 (depth);
2 inch (size) if telescope see back.
 - (5) screen 10 (length), 200 (depth to top);
2 inch (size), brass (material).
 - (6) pump 1/2 h. (HP), 15 (yield gpm);
Electric (type power)
 - (7) electric log no (yes or no)
- (organization running log)

CODED


(8) how well bottom plugged Ballcheck

DRILLERS REMARKS:

MAR 6 1969

If well telescopes please sketch and show depths.

GROUND LEVEL

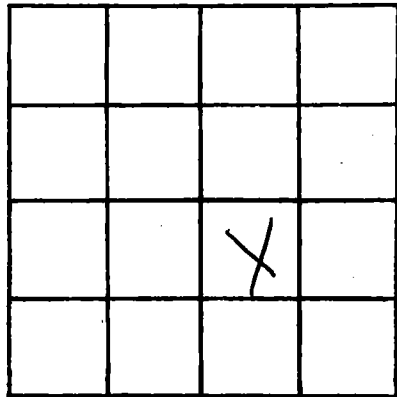

SECTION 17

Please indicate well location X.

ADDITIONAL INFORMATION

If more than one screen, show locations of each on sketch.