

Harrison
L 213
5-8-69

MISSISSIPPI
BOARD OF WATER COMMISSIONERS
416 North State Street
Jackson, Mississippi 39201

CODED

WATER WELL DRILLERS LOG

May 8 1969 M & B Drilling Co Harrison
date well completed firm name county well located

LANDOWNER: Abrace Acan
Coleman Rd - RR.
Culpeper, Miss.
(mailing address)

WELL LOCATION:
sec. 8 T. 7 S. R. 11 E.
3 miles N of Culpeper
(distance) (direction) (nearest town)

WELL PURPOSE: Trailer Park
(home, irrigation, municipal, industrial)

WELL COMPLETION DATA:
(1) diameter (inches) 4 1/2
(2) total depth (feet) 512
(3) static water level (feet) 4" below top of ground.
(4) casing PVC Total
4 1/2 (size) If telescope see back.
(5) screen 12 ft 4 1/2 (length) (depth to top)
2" PVC Sand Pac (size) (material)
(6) pump 1 25 (HP) (yield gpm)
220 v 1 ph Burks Submersible (type power)
(7) electric log No (yes or no)
(organization running log)
(8) how well bottom plugged
2" PVC Cap.

description of formations encountered	from	to
Surface	0	20
Blue Clay	20	50
Sand	50	85
Blue Clay	85	145
Fine Hard Packed Sand	145	225
Blue Clay	225	305
Sand	305	313
Blue Clay	313	367
Sand	367	373
Blue Clay	373	465
Grey Sand	465	512

JUN 2 - 1969

MISS. BD. OF WATER COMMISSIONERS

DRILLERS REMARKS:

If well telescopes please sketch and show depths.

GROUND LEVEL

120 FT →

4" PVC

4x2 PVC
Bushing

2" PVC

496


2" Sand
Pac Screen

508

← 2" PVC

512

→ 2" PVC
egg

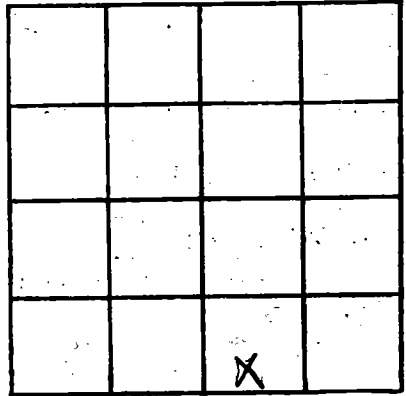

SECTION 8

Please indicate well location X.

ADDITIONAL INFORMATION

If more than one screen, show locations of each on sketch.