

CODED

MISSISSIPPI
BOARD OF WATER COMMISSIONERS
416 North State Street
Jackson, Mississippi 39201

WATER WELL DRILLERS LOG

Harrison
L 215
6-28-69

6-28-69 19 R. J. Moore HARRISON
date well completed firm name county well located

LANDOWNER: Lucy Cook

description of formations encountered	from	to
<u>TOP SOIL Gumbo CLAY</u>	<u>0</u>	<u>30</u>
<u>FINE SAND</u>	<u>30</u>	<u>47</u>
<u>BLUE CLAY</u>	<u>47</u>	<u>80</u>
<u>FINE SAND</u>	<u>80</u>	<u>92</u>
<u>BLUE CLAY</u>	<u>92</u>	<u>160</u>
<u>FINE SAND</u>	<u>160</u>	<u>180</u>
<u>Blue CLAY + SHALE</u>	<u>180</u>	<u>550</u>
<u>BLUE SAND (MED)</u>	<u>550</u>	<u>370</u>

RT 3 Box 56
GULFPORT, MISS
(mailing address)

WELL LOCATION:
sec. 21 T. 7 N. R. 11 E. W
1 miles North of Gulfport
(distance) (direction) (nearest town)

WELL PURPOSE: Home
(hom, irrigation, municipal, industrial)

- WELL COMPLETION DATA:
- (1) diameter (inches) 2"
 - (2) total depth (feet) 370'
 - (3) static water level (feet) 2' above
top of ground.
 - (4) casing 2 1/2", 260'
(material) (depth)
 if telescope see back.
(size)
 - (5) screen 10', 260'
(length) (depth to top)
2", SS
(size) (material)
 - (6) pump ,
(HP) (yield gpm)

(type power)
 - (7) electric log
(yes or no)


(organization running log)
 - (8) how well bottom plugged B.W

~~7-1969~~

DRILLERS REMARKS: DID NOT
DRILL TO BOTTOM OF
SAND

If well telescopes please sketch and show depths.

GROUND LEVEL

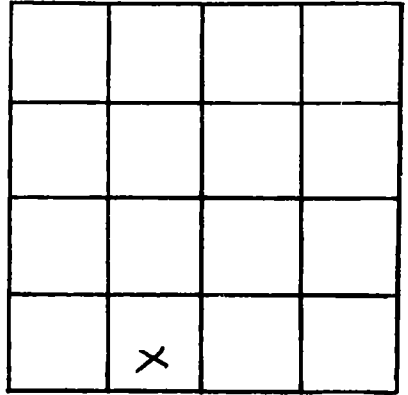

SECTION 21

Please indicate well location X.

ADDITIONAL INFORMATION

If more than one screen, show locations of each on sketch.