

Harrison  
L 218  
6-18-69

MISSISSIPPI  
 BOARD OF WATER COMMISSIONERS CODED  
 416 North State Street  
 Jackson, Mississippi 39201  
 WATER WELL DRILLERS LOG

6-18 1969 date well completed Switzer Well Co. firm name Harrison county well located

LANDOWNER: Ern Stewart  
105 Yada Drive  
Gulfport Miss  
 (mailing address)

WELL LOCATION:  
 sec 5 T 7 S R 11 W  
0 miles N of GULFPORT  
 (distance) (direction) (nearest town)

WELL PURPOSE: Home  
 (home, irrigation, municipal, industrial)


- WELL COMPLETION DATA:
- (1) diameter (inches) 2
  - (2) total depth (feet) 506
  - (3) static water level (feet) 29' 6" below above top of ground.
  - (4) casing gal steel 496'  
 (material) (depth)  
2" if telescope see back.  
 (size)
  - (5) screen 10' 496'  
 (length) (depth to top)  
8ga 55 or pipe  
 (size) (material)
  - (6) pump 1/2 8.5  
 (HP) (yield gpm)  
electric  
 (type power)
  - (7) electric log No  
 (yes or no)
- (organization running log)
- (8) how well bottom plugged Back  
pressure valve

description of formations encountered	from	to
<u>Mixed</u>	<u>0</u>	<u>21</u>
<u>clay</u>	<u>21</u>	<u>40</u>
<u>Mixed</u>	<u>40</u>	<u>143</u>
<u>clay</u>	<u>143</u>	<u>184</u>
<u>Mixed</u>	<u>184</u>	<u>204</u>
<u>clay</u>	<u>204</u>	<u>266</u>
<u>sand</u>	<u>266</u>	<u>269</u>
<u>clay</u>	<u>269</u>	<u>388</u>
<u>Mixed</u>	<u>388</u>	<u>428</u>
<u>clay</u>	<u>428</u>	<u>449</u>
<u>Mixed</u>	<u>449</u>	<u>469</u>
<u>clay</u>	<u>469</u>	<u>472</u>
<u>medium sand</u>	<u>472</u>	<u>506</u>

DRILLERS REMARKS:

If well telescopes please sketch and show depths.

GROUND LEVEL

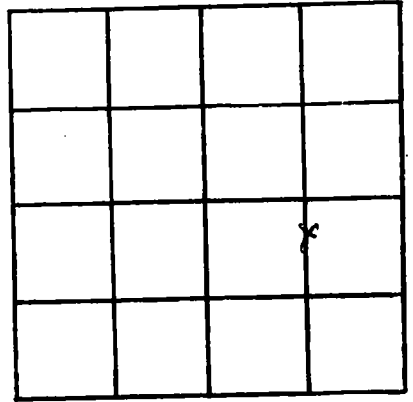

SECTION 5

Please indicate well location X.

ADDITIONAL INFORMATION

A series of horizontal lines for writing additional information.

If more than one screen, show locations of each on sketch.