

Harrison
L 220
7-8-69

MISSISSIPPI
BOARD OF WATER COMMISSIONERS
416 North State Street
Jackson, Mississippi 39201

CODED

WATER WELL DRILLERS LOG

7/8 1969 Switzer Well Co. Harrison
date well completed firm name county well located

LANDOWNER: George D. Hopkins
2706 - 19th St.
Gulfport Miss.
(mailing address)

description of formations encountered	from	to
clay	0	16
Sand	16	22
clay sand streak	22	62
clay	62	74
clay	74	83
clay sand streak	83	101
clay	101	121
clay	121	133
Sand	133	142
clay	142	162
2nd Sand	162	180
Sand	180	183
clay	183	204
clay	204	298
Sand	298	306
clay	306	343
Sand	343	370

WELL LOCATION:
sec. 16 T-7 S R-11 E W
3 1/2 miles N of GULFPORT
(distance) (direction) (nearest town)

WELL PURPOSE: Industrial
(home, irrigation, municipal, industrial)

WELL COMPLETION DATA:

(1) diameter (inches) 4x2

(2) total depth (feet) 370'

(3) static water level (feet) 14' below top of ground

(4) casing gal. Steel 360' (material) (depth)

4x2" if telescope see back. (size)

(5) screen 10' 360' (length) (depth, to top)

8ga SS on pipe (size) (material)

(6) pump 3/4" (HP) (yield gpm)

electric (type power)

(7) electric log no (yes or no)

(organization running log)

(8) how well bottom plugged Back Pressure Valve

DRILLERS REMARKS:

SEP 19 1969


MISS. BD. OF WATER COMMISSIONERS

If well telescopes please sketch and show depths.

GROUND LEVEL

84' OF 4"

276' OF 2"

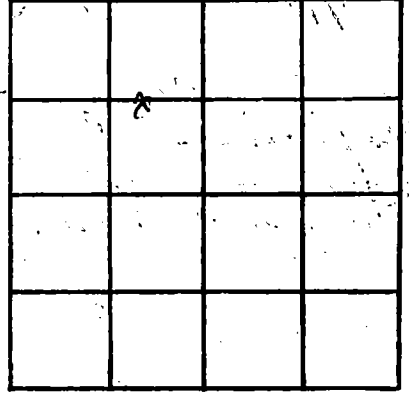

SECTION 16

Please indicate well location X.

ADDITIONAL INFORMATION

If more than one screen, show locations of each on sketch.